

C54

11-66

WATER WELL DRILLERS LOG

Date: 11-5, 1966, Driller: SFR Drilling Co., County LAMAR
1066 Thompson Blvd. Petal, Miss.

(1) Owner of Land: MRS Rhoda B. GREEN
(Name)
RT 2 Columbia, Miss
(Address)
(2) Location: NW 1/4, NW 1/4, Sec. 30 T4 R16,
11 miles EAST of Columbia.
(distance) (direction) (Nearest Town)
(3) Topography: Hilly
(Hilly) (Flat) (Level)
(4) Purpose of Well: HOME
(Domestic Irrigation
Municipal, Industrial, Other)

Description & Color of Materials Sand, Clay, Red Clay, Shell, etc.	Thick- ness Feet	Depth Feet
RED CLAY	10	10
RED SANDY CLAY	10	20
BROWN & WHITE CLAY STRIP	200	220
BLUE SHELL	225	445
FINE SAND	15	460
GOOD SAND	30	490


Information upon completion of well:

(1) Diameter 2 inches.
(2) Total Depth 490 feet.
(3) Water Level 88 feet below top of ground.
(4) Cased to 430, Size 2"
(5) Screen: Size 2", Length 10ft.
(6) Were any formations sealed against pollution?
_____ yes, no.

If YES depth of formation _____

Why _____

Drillers Remarks: _____

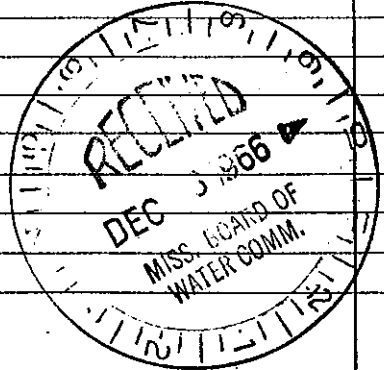

(Use Back Side)

Well No.