

MISSISSIPPI BOARD OF WATER COMMISSIONERS

LAMAR


C56

12-26-63

WATER WELL DRILLERS LOG **CODED**

Date: Dec 26, 1963, Driller: Jay Latt County: Lamar  
(Name)

	Description & Color of Materials Sand, Clay, Red Clay, Shell, etc.	Thick- ness Feet	Depth Feet
(1) Owner of Land: <u>J. C. Moody</u> <small>(Name)</small> <u>Rt 3 Sumrall, Miss</u> <small>(Address)</small>	<u>0'-15' Red Clay</u>		
(2) Location: <u>1/4, 1/4, Sec. 26 T. 16 R. 16</u> <u>12 miles South of Sumrall</u> <small>(distance) (direction) (Nearest Town)</small>	<u>15-35 Red Sand</u>		
(3) Topography: <u>Level</u> <small>(Hilly) (Flat) (Level)</small>	<u>35-60 yellow Sand</u>		
(4) Purpose of Well: <u>Domestic</u> <small>(Domestic Irrigation Municipal, Industrial, Other)</small>	<u>60-140 white Clay</u>		
Information upon completion of well:			
(1) Diameter: <u>2</u> inches.			
(2) Total Depth: <u>162</u> feet.			
(3) Water Level: <u>94</u> feet below top of ground.			
(4) Cased to _____, Size _____.			
(5) Screen: Size <u>2"</u> , Length <u>6ft.</u>			
(6) Were any formations sealed against pollution? _____yes, _____no.			
If YES depth of formation _____			
Why _____			
Drillers Remarks: _____			
_____			
_____			
_____			Well No.

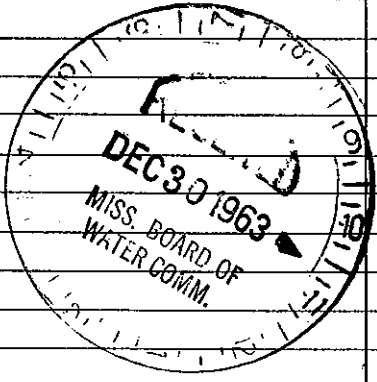

**CODED**

(Use Back Side)

Mail this copy to Board of Water Commissioners 429 Miss. St. Jackson, Miss.