

LAMAR MISSISSIPPI BOARD OF WATER COMMISSIONERS

EG

4-15-66

WATER WELL DRILLERS LOG

Date: 4-15, 1966, Driller: SJR Drilling County Lamar
(Name)

(1) Owner of Land: <u>Bob Touchstone</u> <small>(Name)</small>	Description & Color of Materials Sand, Clay, Red Clay, Shell, etc.	Thick- ness Feet	Depth Feet
<u>Hattiesburg, Miss</u> <small>(Address)</small>	<u>Red Sandy Clay</u>	<u>17</u>	<u>17</u>
(2) Location: <u>NE 1/4, SE 1/4, Sec. 16, T4, R12</u>	<u>Red fine Sand</u>	<u>11</u>	<u>28</u>
<u>8</u> miles <u>West</u> of <u>Hattiesburg</u> <small>(distance) (direction) (Nearest Town)</small>	<u>Red + White Clay</u>	<u>37</u>	<u>65</u>
(3) Topography: <u>Hilly</u> <small>(Hilly) (Flat) (Level)</small>	<u>Brown Clay</u>	<u>36</u>	<u>101</u>
(4) Purpose of Well: <u>Home</u> <small>(Domestic Irrigation, Municipal, Industrial, Other)</small>	<u>Blue Clay</u>	<u>57</u>	<u>152</u>
	<u>Strip White Clay Sand</u>	<u>13</u>	<u>165</u>
	<u>good white Sand</u>	<u>10</u>	<u>175</u>
	<u>Sand Rock</u>	<u>1/2</u>	<u>175 1/2</u>
	<u>Red Sand</u>	<u>1 1/2</u>	<u>177</u>
	<u>Rocks (Hard)</u>	<u>4</u>	<u>181</u>


Information upon completion of well:

- (1) Diameter 2 inches.
- (2) Total Depth 175 feet.
- (3) Water Level 155 feet below top of ground.
- (4) Cased to 170, Size 2"
- (5) Screen: Size 2", Length 5 ft
- (6) Were any formations sealed against pollution?
 yes, no.

If YES depth of formation _____

Why _____

Drillers Remarks: _____

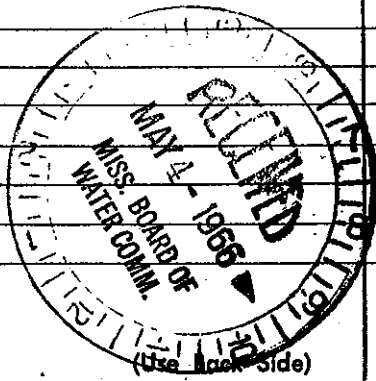

Well No. 95

Mail this copy to Board of Water Commissioners 429 Miss. St. Jackson, Miss