

LAMAR MISSISSIPPI BOARD OF WATER COMMISSIONERS

CODED

WATER WELL DRILLERS LOG

D11
5-6-61

Date: 5-6, 1961, Driller: Jay Rott County: Lamar
(Name)

	Description & Color of Materials Sand, Clay, Red Clay, Shell, etc.	Thick- ness Feet	Depth Feet
(1) Owner of Land: <u>R. P. Rawls</u> (Name) <u>Rt 4, Nattiesburg, Miss</u> (Address)	<u>Red Sand</u> <u>white "</u>	<u>20</u> <u>20-60</u>	
(2) Location: <u>1/4</u> , <u>1/4</u> , Sec. <u>1</u> T <u>9R15</u> , <u>15</u> miles <u>N</u> of <u>Nattiesburg</u> (distance) (direction) (Nearest Town)			
(3) Topography: <u>Hilly</u> (Hilly) (Flat) (Level)			
(4) Purpose of Well: <u>Domestic</u> (Domestic Irrigation Municipal, Industrial, Other)			

Information upon completion of well:

(1) Diameter 9 inches.

(2) Total Depth 60 feet.

(3) Water Level 45 feet below top of ground.

(4) Cased to bottom, Size 2 in.

(5) Screen: Size 2 in., Length 5 ft.

(6) Were any formations sealed against pollution?
 yes, no.


If YES depth of formation _____

Why _____

Drillers Remarks: _____

CODED

Similar info
and same name
as already scheduled
for well D11

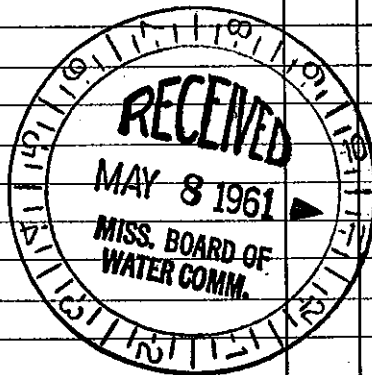

(Use Back Side)

Well No.

Mail this copy to Board of Water Commissioners 429 Miss. St. Jackson, Miss