


MISSISSIPPI BOARD OF WATER COMMISSIONERS

LAMAR
D 49

WATER WELL DRILLERS LOG

Date: 11-25-60, 1960, Driller: Times County Lamar
(Name)

	Description & Color of Materials Sand, Clay, Red Clay, Shell, etc.	Thick- ness Feet	Depth Feet
(1) Owner of Land: <u>Adrian Ball</u> (Name) <u>Jetal, Miss</u> (Address)	<u>0-40 Clay</u> <u>40-78 Sand</u>		
(2) Location: <u>SE 1/4, SW 1/4, Sec. 11 T. 10 N.</u> <u>10</u> miles <u>west</u> of <u>Hattiesburg</u> (distance) (direction) (Nearest Town)			
(3) Topography: <u>Hilly</u> (Hilly) (Flat) (Level)			
(4) Purpose of Well: <u>Home</u> (Domestic Irrigation, Municipal, Industrial, Other)			
Information upon completion of well:			
(1) Diameter <u>2"</u> inches.			
(2) Total Depth <u>75</u> feet.			
(3) Water Level <u>47</u> feet below top of ground.			
(4) Cased to <u>72</u> , Size <u>2"</u>			
(5) Screen: Size <u>2"</u> , Length <u>5 ft.</u>			
(6) Were any formations sealed against pollution? <u>no.</u>			
If YES depth of formation _____			
Why _____			
Drillers Remarks: _____			

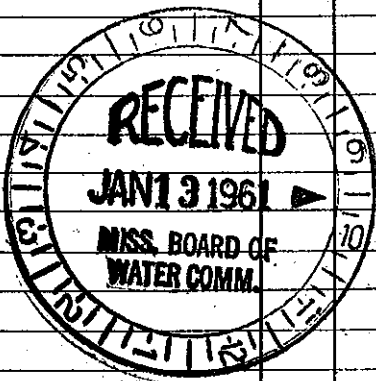

(Use Back Side)

Mail this copy to Board of Water Commissioners 429 Miss. St. Jackson, Miss.