

LAMAR  
D  
2-68

MISSISSIPPI  
BOARD OF WATER COMMISSIONERS  
416 North State Street  
Jackson, Mississippi 39201

D54  
CODED

WATER WELL DRILLERS LOG


3/29 1968 STR LeSODEN  
date well completed firm name county well located

LANDOWNER: Oral Taylor description of formations encountered from to  
RT 1  
Sumrell  
(mailing address)

WELL LOCATION:  
sec. 11 T. 4 N R. 15 E  
9 miles W of Hattiesburg  
(distance) (direction) (nearest town) CODED

WELL PURPOSE: Home  
(home, irrigation, municipal, industrial)

- WELL COMPLETION DATA:
- (1) diameter (inches) 2"
  - (2) total depth (feet) 50
  - (3) static water level (feet) 31 below above top of ground.
  - (4) casing plastic 45' (material) (depth)  
2" (size) if telescope see back.
  - (5) screen 5 ft 45' (length) (depth to top)  
2" (size) plastic (material)
  - (6) pump 1/2 300 Hc (HP) (water pump)  
1/2 (type power)
  - (7) electric log no (yes or no)  
none (organization running log)
  - (8) how well bottom plugged value

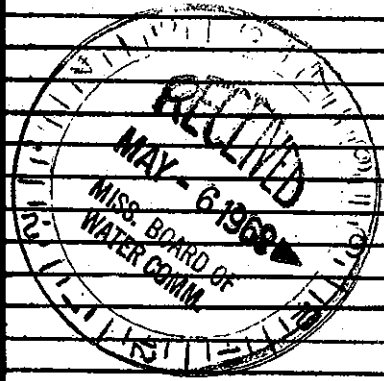

DRILLERS REMARKS: