

LAMAR
D
4-68

MISSISSIPPI
BOARD OF WATER COMMISSIONERS
416 North State Street
Jackson, Mississippi 39201

CODED

D55

WATER WELL DRILLERS LOG


4/26 1968 date well completed
S.R. firm name
Lamar county well located

LANDOWNER	description of formations encountered	from	to
John M. Clark			
RT 1			
Sumner, Miss (mailing address)	Amalgam Clay	0	10
	Gravelly Clay	10	20
	White Clay	20	40
	Fine Sand	40	60
	Dark Clay	60	80
	Fine Sand	80	100
	C. M. B. Sand	100	135

WELL LOCATION:
sec. 2 T 4 N R 15 E
S W
8 miles W of Natchez (distance) (direction) (nearest town)

WELL PURPOSE:
(home, irrigation, municipal, industrial)

- WELL COMPLETION DATA:
- diameter (inches) 2"
 - total depth (feet) 135
 - static water level (feet) 85' below above top of ground.
 - casing (material) (depth) 130', 2" (size) If telescope see back.
 - screen (length) (depth to top) 5 ft, 130', 2" (size) (material) plastic
 - pump (HP) (yield gpm) 1, 470, jet (type power)
 - electric log (yes or no) no (organization running log) None
 - how well bottom plugged Valve

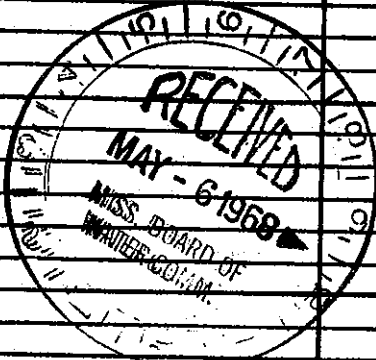

DRILLERS REMARKS: