

CODED

LAMAR
D
3-68

MISSISSIPPI
BOARD OF WATER COMMISSIONERS
416 North State Street
Jackson, Mississippi 39201

D56

WATER WELL DRILLERS LOG

Lamar

3/9 1968 SFR ~~Forest~~
date well completed firm name county well located


LANDOWNER: *W.B. Tarkenton*
PT-1
City Summer
(mailing address)

description of formations encountered	from to	
<i>Gravelly Clay</i>	0	35
<i>Reddish Clay</i>	35	55
<i>Gravelly Sand & Gravel</i>	55	70
<i>P.W. B. Sand</i>	70	85

WELL LOCATION:
sec. *36* T *4* N *15* E
S W
9 miles *W* of *Waltham*
(distance) (direction) (nearest town)

WELL PURPOSE: *Home*
(home, irrigation, municipal, industrial)

- WELL COMPLETION DATA:
- (1) diameter (inches) *2"*
 - (2) total depth (feet) *85*
 - (3) static water level (feet) *57* below above top of ground.
 - (4) casing *plastic*, *80*,
(material) (depth)
2"
(size) if telescope see back.
 - (5) screen *5 ft*, *80 ft*
(length) (depth to top)
2", *plastic*
(size) (material)
 - (6) pump *3/4*, *350 Hr*
(HP) (horsepower)
1st
(type power)
 - (7) electric log *no*
(yes or no)
None
(organization running log)
 - (8) how well bottom plugged *None*

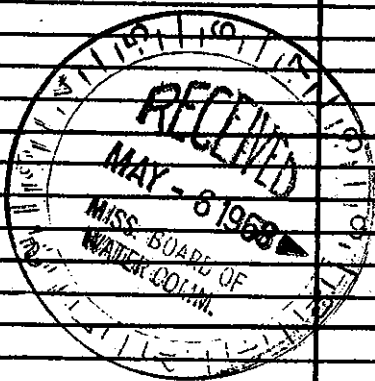

DRILLERS REMARKS: