

Lamar
 DGI
 9-16-68

MISSISSIPPI
 BOARD OF WATER COMMISSIONERS
 416 North State Street
 Jackson, Mississippi 39201

CODED

WATER WELL DRILLERS LOG

9/16 1968 date well completed
 STR firm name
 Lamar county well located


LANDOWNER: <u>F. R. Douglas</u>	description of formations encountered	from	to
<u>RTS</u> <u>Sumner Miss.</u> (mailing address)			
	Clay	0	20
	Soft Clay	20	40
	Clay	40	90
	PW & Sand	90	105

WELL LOCATION:
 19 Sec ~~7~~ T ~~4~~ N ~~15~~ R ~~3~~ E
 S W
 1/4 miles W of H. Run
 (distance) (direction) (nearest town)

WELL PURPOSE: Home
 (home, irrigation, municipal, industrial)

- WELL COMPLETION DATA:
- (1) diameter (inches) 2"
 - (2) total depth (feet) 105
 - (3) static water level (feet) 66 below top of ground.
 - (4) casing plastic (material), 100 (depth)
2" (size) if telescope see back.
 - (5) screen 5 ft (length), 100 (depth to top)
2" (size), plastic (material)
 - (6) pump 1 (HP), 740 G.P.M. (yield gpm)
Star (type power)
 - (7) electric log (yes or no)
 (organization running log)
 - (8) how well bottom plugged None

CODED

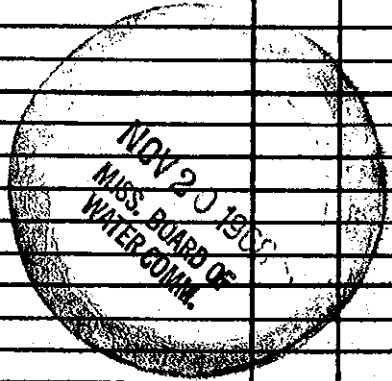

DRILLERS REMARKS: