

Leman  
D63  
9-23-68


MISSISSIPPI  
BOARD OF WATER COMMISSIONERS  
416 North State Street  
Jackson, Mississippi 39201

CODED

WATER WELL DRILLERS LOG

9/23 1968 S+R Leman  
date well completed firm name county well located

LANDOWNER: Frank Knight.  (mailing address)	description of formations encountered	from	to
WELL LOCATION: sec 33 T 4 N R 15 E S          W 1.2 miles W of Hwy (distance) (direction) (nearest town)  WELL PURPOSE: Home (home, irrigation, municipal, industrial)  WELL COMPLETION DATA: (1) diameter (inches) 4" (2) total depth (feet) 418 (3) static water level (feet) 204 below above top of ground. (4) casing 4x2 (material) 403 (depth) 4x2 (size) if telescope see back. (5) screen 15 (length) 403 (depth to top) 2" (size) 5/5 (material) (6) pump 1 (HP) 800 G.P.M. (yield gpm) Sub (type power) (7) electric log (yes or no) (organization running log) (8) how well bottom plugged Valve	Brown + white clay Sand Sand Blue Clay Brown + white clay Sand Blue clay Sand Sand White Clay Sand White Clay C.W.B. Sand Blue Clay	0 38 40 41 41 78 90 110 148 197 197 202 231 234 296 418	38 40 41 78 90 110 148 197 202 231 234 296 418

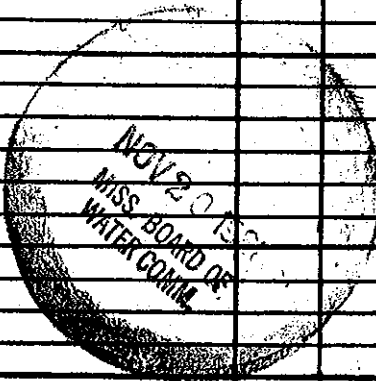

DRILLERS REMARKS:  
4 1/2" 2" Pipe Set in Clay for Sewer Sump Pipe