

LAMAR

MISSISSIPPI BOARD OF WATER COMMISSIONERS

~~7-30-60~~ D81  
7-30-60

WATER WELL DRILLERS LOG

**CODED**

Date: 7-30, 1960, Driller: Dick & Grace County Lamar  
(Name)

(1) Owner of Land	Description & Color of Materials Sand, Clay, Red Clay, Shell, etc.	Thick- ness Feet	Depth Feet
<u>Jahmie Nobles</u> (Name) <u>Hattiesburg RFD.</u> (Address)	<u>Surface Sand</u>	<u>0</u>	<u>30</u>
(2) Location: <u>1/4</u> , <u>1/4</u> , Sec. <u>32</u> T. <u>15</u> R. <u>15</u>	<u>White Chalk clay.</u>	<u>30</u>	<u>80</u>
<u>18</u> miles <u>SW</u> of <u>Hattiesburg</u> (distance) (direction) (Nearest Town)	<u>good white sand</u>	<u>80</u>	<u>104</u>
(3) Topography: <u>Flat</u> (Hilly) (Flat) (Level)			
(4) Purpose of Well: (Domestic Irrigation Municipal, Industrial, Other)			

**CODED**


Information upon completion of well:

- (1) Diameter 2 inches.
- (2) Total Depth 104 feet.
- (3) Water Level 84 feet below top of ground.
- (4) Cased to \_\_\_\_\_, Size \_\_\_\_\_
- (5) Screen: Size 2", Length 5'
- (6) Were any formations sealed against pollution?  
\_\_\_\_\_ yes, No no.

If YES depth of formation \_\_\_\_\_

Why \_\_\_\_\_

Drillers Remarks: Well was hard to develop - may not last too long

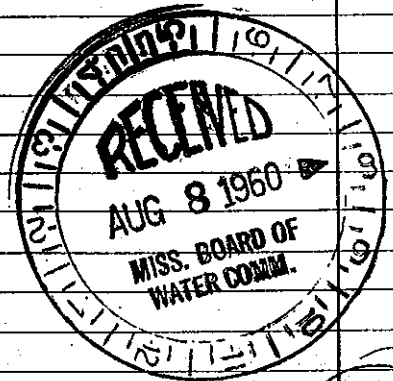

Well No. 8

(Use Back Side)

This copy to Board of Water Commissioners 429 Miss. St. Jackson. Miss.