	State W	ell Report	For Office Use Only:			
County: Lamar	Part 1 – Driller's Log					
	Mississippi Department of Environmental Quality Office of Land and Water Resources		Aquifer:			
Permit #: 0-586		a water Resources Box 2309	Well #: D 188			
Driller. JAMES WELLS	Jackson, MS 39225 (601)961- 5210		L. S. Elevation:			
Date drilling completed: 7-2-1	(601)961	I- 5228 (fax)	E-log #:			
i			-			
State Law requires that this repor	t be prepared by the lice	ense holder responsible jor l Intion of drilling of the well	or borehole.			
Department at the above address within 30 days of completion of drilling of the well or borehole. Information on Well Owner Well or Borehole Location						
(Landowner if borehole is not fo	/winci		<u>" Longitude: 89 • 28 • 51 "</u>			
Owner Name Robert Jan	vs. Jr.					
Mailing Address: 1814 Old Hu		Method of Lat/Long (circle or	ng (circle one): Conventional Survey,			
Mailing Address: 1017 019 114			GPS, Survey-grade GPS			
NW 1/ SW 1/ Sec 24			Twn YN Rng 15W			
Hatties Dure (1) 37700						
0,			of Hattiesburg			
Telephone No. (60) 268-31	00	х.				
	Well / Bore	hole Data				
Date drilling started: 7-2-11 Date drilling completed: 7-2-11 Hole depth: 95 Hole diameter: 7'3'						
Location of the source of any surface water used for drilling: <u>Campunity</u> Method of dosing and volume of Chlorine used in drilling and development: <u>Shack</u>						
Logs run (circle all applicable): No log run Electric Gamma Ray Density Sonic Neutron Other:						
Purpose of borehole (check one): Water Well Geotechnical/Geological Investigation Ground Source Heat Pump						
Seismic SurveyOther (describe)						
If drilling is not related to water well construction, skip the remainder of this block						
Purpose of Well (check one): Home Z Industrial Public Supply Irrigation Fish Culture Other:						
If a flowing well, method of flow regulation: Valve Other (describe)						
Static Water Level: 60 feet above of below (circle one) land surface Date measured: 7-2-1/						
Method of Measurement (circle one) electric tape air line other:						
Well depth: <u>98</u> Well grouted to a depth of <u>10</u> feet Type of grout (circle one): Neat Cement Bentonite Mix						
Casing length: 78 feet Casing diameter: 4 inches Type of casing: PUC						
Screen length: <u>D</u> feet Screen diameter: <u>4</u> inches Type of screen: <u>PVC</u>						
Screen slot size:						
Type of completion (circle all applicable): Gravel packed Underreamed Telescoped Open hole Natural Development						
Other (describe):						
Top of lap pipe or reduction in casing:	feet. If te	lescoped or more than one scre				
L			Form: OLWR-SWR-1A (04/08			

RECEIVEL

AUG 1 9 2011



Description of formations encountered must be provided for all


wells and boreholes, unless specifically exempted by regulations

The sketch below only required for water wells

If well telescopes, show depths on sketch. Ground Level

round Level	Description of Formations Encountered	From (depth)	To (depth)
	topsoil Clay	Ground Level	
	clay	65	6 5 98
	56nd	65	98
		-	
			_
	······································		
		_	
			_

If more than one screen, show location of each on sketch

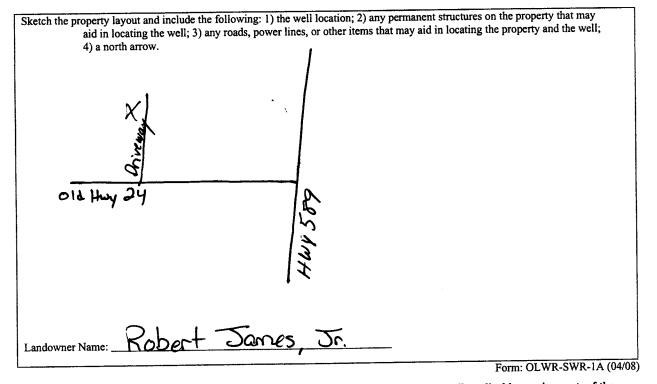

I certify that the well/borehole was drilled, constructed, and completed in accordance with all applicable requirements of the Mississippi Department of Environmental Quality and the Mississippi Department of Health regulations, if applicable, and state

JAMES WELLS 0-586_

Print Name of Responsible Licensee and License No.

Date

amon Walls


Signature of Licensee

AUG 1 5 2011



х	STATE WI	ELL REPORT		
County: <u>Lamar</u> Permit #:	Pump Installer's Mississippi Departmen Office of Land a	art 2 s Completion Report at of Environmental Quality and Water Resources Box 10631	For Office Use Only:	
Driller: <u>JAMES WELLS</u> Date completed: <u>7-2-11</u>	Jackson, M (601)	45 39289-0631 961-5210 4-6938 (fax)	Well #: D 188	
This report should be prepared by th	e pump installer in deta			
installation of pump. Well Owner Information		Well Localing		
Owner Name: Robert James, Jr. Mailing Address: 1814 Old Hwy 24 Hattiesburg MS 39402 City State Zip Code. Telephone No. (LU) 268-2128		Latitude: 31-16-40 Longitude: 89-28-51 Method of Lat/Long (circle one): Conventional Survey,		
				USGS quad, Hand-held GPS, Survey-grade GPS <u>NW 14 SW 14 Sec 26 Twn 40 Rng 1560</u> Direction Nearest Town
		Distance Direction $\underline{\omega}$ Miles $\underline{\omega}$		
		Pump Type Circle one		Power Type Circle one
Air Lift Jet	Submersible	Diesel Engine Gasol	ine Engine Natural Gas	
Bucket Piston	Turbine <	Electric Motor Hand	Tractor PTO	
Centrifugal Rotary	Flowing Well	11 Manual Contraction	r (specify):	
Other (specify): Date Pump Installed: Rated Pump Capacity:		Horse Power Rating of Moto Setting Depth:90 Number of Stages:/	917:	
Rated Pump Capacity:				
Pump Test Data	l	Method of M	feasuring Water Level Circle one	
	et Below Land Surface	Air Line Electric M Other (specify):	easuring Line Steel Tape	
	et Below Land Surface	For flowing well, measured	shut in head:feet	
Test Pumping Rate:	Gallons Per Minute s):hours	Well yielded	GPM with a drawdown of 	
I HEREBY CERTIFY that the above stat <u>JAMES</u> <u>WELLS</u> Print Name of Pump Installer and Licens	0-586	a of my knowledge.	D Wells	
1 1 1411 France VI & whip and and a second			BEUENED	

-

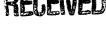

AUG 1 9 2011

BY: OLWR