

Lamar
 EQ4
 8-26-68

MISSISSIPPI
 BOARD OF WATER COMMISSIONERS
 416 North State Street
 Jackson, Mississippi 39201

CODED

WATER WELL DRILLERS LOG

8/26 1968 STR Lamar
 date well completed firm name county well located


LANDOWNER: John Tuller	description of formations encountered	depth	
		from	to
	Clay	0	20
Hathorn Min. (mailing address)	Sand & Clay	20	40
	Red Sand	40	50
	Clay & Sand	50	60

WELL LOCATION:
 sec 18 T 4 N R 14 E
 S W
 7 miles W of Hbmg
 (distance) (direction) (nearest town)

WELL PURPOSE: Home
 (home, irrigation, municipal, industrial)

- WELL COMPLETION DATA:
- (1) diameter (inches) 4"
 - (2) total depth (feet) 60
 - (3) static water level (feet) 15' below top of ground.
 - (4) casing plastic 55' (material) (depth)
 4" (size) if telescope see back.
 - (5) screen 5 ft 55' (length) (depth to top)
 4" (size) plastic (material)
 - (6) pump 1/2 (HP) 1800 GPM (yield gpm)
 Sub. (type power)
 - (7) electric log _____ (yes or no)
 _____ (organization running log)
 - (8) how well bottom plugged Value

CODED

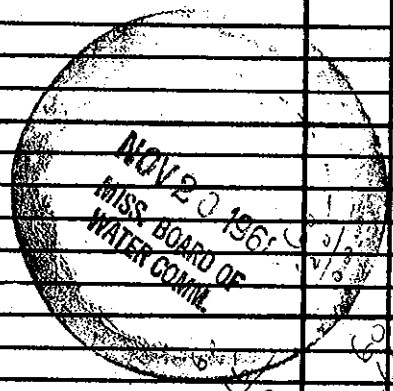

DRILLERS REMARKS: