

LAMAR
E
2-68

MISSISSIPPI
BOARD OF WATER COMMISSIONERS
416 North State Street
Jackson, Mississippi 39201

RODED
E82

WATER WELL DRILLERS LOG

Feb 16 1968 STR
date well completed firm name county well located


LANDOWNER: Jack Church
Pt 1
Hattiesburg Miss
(mailing address)

description of formations encountered	depth	
	from	to
hard clay	0	12
fine sand	12	98
concrete w B S	98	58

WELL LOCATION:
sec 23 T 4 N R 14 E
S W
2 miles W of Hattiesburg
(distance) (direction) (nearest town)

WELL PURPOSE: Home
(home, irrigation, municipal, industrial)

- WELL COMPLETION DATA:
- diameter (inches) 4"
 - total depth (feet) 38 ft
 - static water level (feet) 16 below top of ground.
 - casing PVC, 33 ft (material), (depth)
2" (size) if telescope see back.
 - screen 5 ft, 33 ft (length), (depth to top)
2" (size), PVC (material)
 - pump 3/4 (HP), 1200 gpm (yield gpm)
P.L.P.O. (type power)
 - electric log NO (yes or no)
(organization running log)
 - how well bottom plugged false

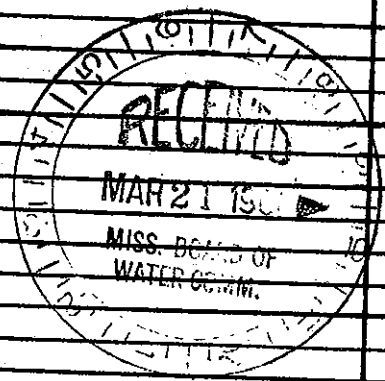

DRILLERS REMARKS: