

LAMAR
 E 12
 5-6-61

MISSISSIPPI BOARD OF WATER COMMISSIONERS

WATER WELL DRILLERS LOG

Date: 5-6, 1961, Driller: Jay Holt County Lamar
 (Name)

	Description & Color of Materials Sand, Clay, Red Clay, Shell, etc.	Thick- ness Feet	Depth Feet
(1) Owner of Land: <u>Henry Hemington</u> (Name)	<u>Red Sand</u>		<u>80</u>
<u>St. 4, Hattiesburg, Miss</u> (Address)	<u>White Clay</u>	<u>80-150</u>	
(2) Location: <u>NW 1/4, SE 1/4, Sec. 18 T. 4 R. 15</u>	<u>Blue "</u>	<u>150-190</u>	
<u>2</u> miles <u>W</u> of <u>Hattiesburg</u> (distance) (direction) (Nearest Town)	<u>White sand</u>	<u>190-220</u>	
(3) Topography: <u>Hilly</u> (Hilly) (Flat) (Level)	<u>Blue Clay</u>	<u>220-260</u>	
(4) Purpose of Well: <u>Domestic</u> (Domestic Irrigation Municipal, Industrial, Other)	<u>" Sand</u>	<u>260-313</u>	


Information upon completion of well:

- (1) Diameter 9 inches.
- (2) Total Depth 313 feet.
- (3) Water Level 146 feet below top of ground.
- (4) Cased to bottom, Size 2 in.
- (5) Screen: Size 2 in., Length 10 ft.
- (6) Were any formations sealed against pollution?
 yes, no.

If YES depth of formation _____

Why _____

Drillers Remarks: _____

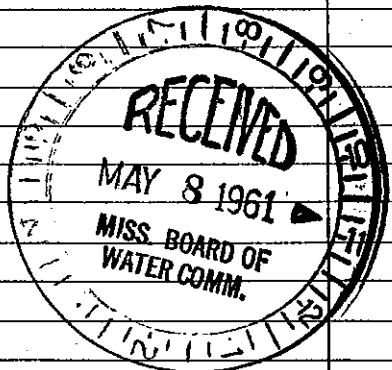

(Use Back Side)

Well No.

Mail this copy to Board of Water Commissioners 429 Miss. St. Jackson, Miss.