

LAMAR MISSISSIPPI BOARD OF WATER COMMISSIONERS

E 13  
7-2-60

WATER WELL DRILLERS' LOG

Lamar?

Date: 7-2, 1960, Driller: Quick & Grice County Franklin  
(Name)


(1) Owner of Land: Hal Fox  
(Name)  
Hattiesburg Miss.  
(Address)

(2) Location: 1/4, 1/4, Sec.     T.     R.      
2 miles west, of Hburg  
(distance) (direction) (Nearest Town)

(3) Topography:  (Hilly)  (Flat)  (Level)

(4) Purpose of Well: Domestic  
(Domestic Irrigation, Municipal, Industrial, Other)

Description & Color of Materials Sand, Clay, Red Clay, Shell, etc.	Thick- ness Feet	Depth Feet
Surface clay Red + White	0	80
Surface sand "Dry"	80	112
Clay, Shale + Fine sand	112	430
Sand Fine to better	430	513

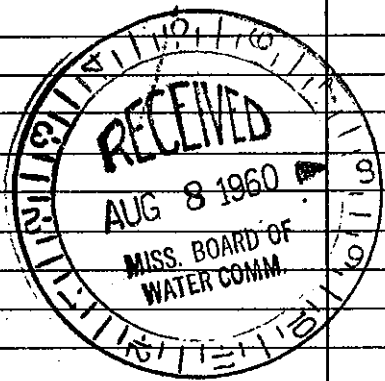

Information upon completion of well:

(1) Diameter 4 inches.

(2) Total Depth 513 feet.

(3) Water Level 90 feet below top of ground.

(4) Cased to    , Size    .

(5) Screen: Size 4", Length 10'.

(6) Were any formations sealed against pollution?  
    yes,  no.

If YES depth of formation    

Why    

Drillers Remarks: we set @  
112' but could not  
develop

Total Depth  
513'

Well No. 1

(Use Back Side)

Mail this copy to Board of Water Commissioners 429 Miss. St. Jackson, Miss.