

LAMAR MISSISSIPPI BOARD OF WATER COMMISSIONERS

E71
10-21-61

WATER WELL DRILLERS LOG

CODED

Date: 10-21, 1961, Driller: HERMAN PARKER county JACKSON
(Name)

(1) Owner of Land: <u>P. H. M^{rs} FINTASH</u> (Name)	Description & Color of Materials Sand, Clay, Red Clay, Shell, etc.	Thick- ness Feet	Depth Feet
<u>104 AZTEC ST. H. BUEL, MISS</u> (Address)	<u>Blue Chalk</u>	<u>335</u>	<u>335</u>
(2) Location: _____ 1/4, _____ 1/4, Sec. <u>6</u> T. <u>R.</u>	<u>" Shell</u>	<u>176</u>	<u>511</u>
<u>6</u> miles <u>West</u> of <u>H</u>	<u>SAND</u>	<u>11</u>	<u>518</u>
(distance) (direction) (Nearest Town)	<u>Chalk</u>	<u>111</u>	<u>629</u>
(3) Topography: <u>Hilly</u>	<u>Shell</u>	<u>157</u>	<u>786</u>
(Hilly) (Flat) (Level)	<u>SAND</u>	<u>29</u>	<u>815</u>
(4) Purpose of Well: <u>Domestic</u> (Domestic Irrigation Municipal, Industrial, Other)			

Information upon completion of well:


- (1) Diameter 2 inches.
- (2) Total Depth 815 feet.
- (3) Water Level 149' feet below top of ground.
- (4) Cased to 815, Size 2"
- (5) Screen: Size 2", Length 5'
- (6) Were any formations sealed against pollution?
_____ yes, no no.

If YES depth of formation _____

Why _____

Drillers Remarks: _____

CODED

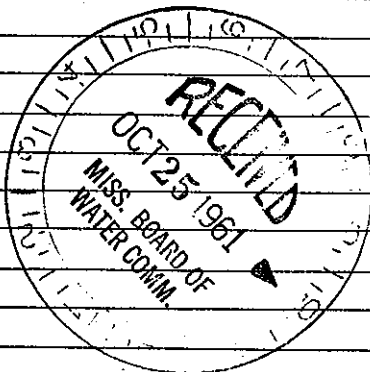

36

Well No.

(Use Back Side)

Mail this copy to Board of Water Commissioners 429 Miss. St. Jackson, Miss.