

LAMAR MISSISSIPPI BOARD OF WATER COMMISSIONERS

E72

12-17-64

WATER WELL DRILLERS LOG

Date: Dec 17, 1964, Driller: Central Milling & Supply County Lamar
(Name)

(1) Owner of Land:	Description & Color of Materials Sand, Clay, Red Clay, Shell, etc.	Thick- ness Feet	Depth Feet
<u>Mr. L.O. English</u> <small>(Name)</small>	<u>red clay</u>	<u>8</u>	<u>8</u>
<u>Oak Grove Road</u> <small>(Address)</small>	<u>chalk</u>	<u>30</u>	<u>38</u>
<u>Kathieburg, Miss.</u> <small>(Address)</small>	<u>dirty sand</u>	<u>2</u>	<u>40</u>
(2) Location: <u>NE 1/4, SW 1/4, Sec 23 T4 R14</u>	<u>chalk</u>	<u>8</u>	<u>48</u>
<u>4</u> miles <u>SW</u> of <u>Kathieburg</u>	<u>fine sand</u>	<u>2</u>	<u>50</u>
<small>(distance) (direction) (Nearest Town)</small>	<u>blue chalk</u>	<u>92</u>	<u>142</u>
(3) Topography: <u>hilly</u>	<u>streaks of chalk & sand</u>	<u>10</u>	<u>152</u>
<small>(Hilly) (Flat) (Level)</small>	<u>med coarse sand</u>		
(4) Purpose of Well: <u>domestic</u>	<u>grey</u>	<u>16</u>	<u>168</u>
<small>(Domestic Irrigation Municipal, Industrial, Other)</small>	<u>chalk</u>	<u>1</u>	<u>169</u>
	<u>stopped on chalk</u>		


Information upon completion of well:

- (1) Diameter 2" inches.
- (2) Total Depth 168' feet.
- (3) Water Level 159' feet below top of ground.
- (4) Cased to 162', Size 2"
- (5) Screen: Size 1/4", Length 5'
8 slot Johnson SS.
- (6) Were any formations sealed against pollution?
no

If YES depth of formation _____

Why _____

Drillers Remarks: _____

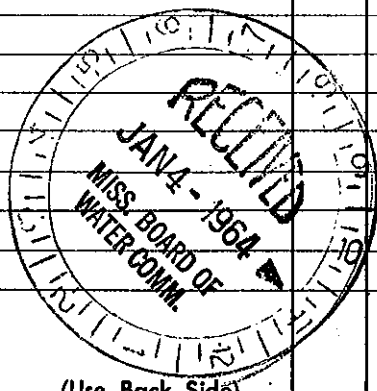

Well No. _____

(Use Back Side)

Mail this copy to Board of Water Commissioners 429 Miss. St. Jackson, Miss.