

MISSISSIPPI BOARD OF WATER COMMISSIONERS

LAMAR  
E 77  
9-9-63

WATER WELL DRILLERS LOG **CODED**


Date: 9/9/63, 1963, Driller: Jay Latt County Lamar  
(Name)

(1) Owner of Land: <u>Miles Rainey</u> (Name)	Description & Color of Materials Sand, Clay, Red Clay, Shell, etc.	Thick- ness Feet	Depth Feet
<u>Rt 4 Hwy</u> (Address)	<u>0'-12' gravel</u>		
(2) Location: <u>1/4, 1/4, Sec. 19, 15, 23 T. 4 R. 14</u>	<u>12'-16' Red Clay</u>		
<u>1/2</u> miles <u>of Oak Grove</u> (distance) (direction) (Nearest Town)	<u>16-34 White Clay</u>		
(3) Topography: <input checked="" type="checkbox"/> (Hilly) <input type="checkbox"/> (Flat) <input type="checkbox"/> (Level)	<u>34-48 Red Clay</u>		
(4) Purpose of Well: _____ (Domestic Irrigation, Municipal, Industrial, Other)	<u>48-90 White Clay</u>		
	<u>90-96 Rock</u>		
	<u>96-160 Blue Clay</u>		
	<u>160-165 Blue Sand</u>		
	<u>165-230 Blue Clay</u>		
	<u>230-258 Blue Sand</u>		

Information upon completion of well:

- (1) Diameter 2 inches.
- (2) Total Depth 258 feet.
- (3) Water Level 160 feet below top of ground.
- (4) Cased to \_\_\_\_\_, Size \_\_\_\_\_.
- (5) Screen: Size 2, Length 10.
- (6) Were any formations sealed against pollution?  
\_\_\_\_\_ yes, \_\_\_\_\_ no.

**CODED**

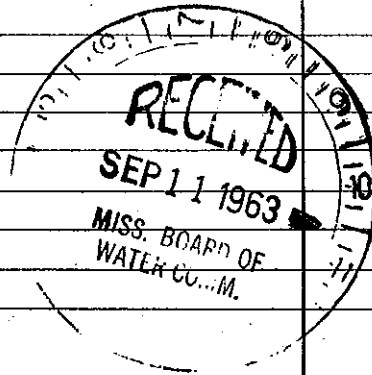

(Use Back Side)

Well No.

Mail this copy to Board of Water Commissioners 429 Miss. St. Jackson, Miss.