

LAMAR
E-78
9-6-63

MISSISSIPPI BOARD OF WATER COMMISSIONERS

WATER WELL DRILLERS LOG

CODED

Date: 9/6/ 1963, Driller: Jay. Lott County Lamar
(Name)

(1) Owner of Land: Miles Rainey
(Name)
RT 4
(Address) Hattiesburg, Miss

(2) Location: 1/4, 1/4, Sec. 15 T. 4 R. 14
miles (distance) of Oak Grove (Nearest Town)

(3) Topography: (Hilly) (Flat) (Level)

(4) Purpose of Well: _____
(Domestic Irrigation, Municipal, Industrial, Other)

Description & Color of Materials Sand, Clay, Red Clay, Shell, etc.	Thick- ness Feet	Depth Feet
0 - 5' Red Clay		
5' - 7' gravel		
7' - 30' Red Clay		
30' - 40' white clay		
40' - 70 Blue clay		
70' - 75 fine sand		
75' - 145 blue clay		
145' - 160 blue sand		
160' - 170 blue clay		
170' - 220 Blue sand		

Information upon completion of well:

(1) Diameter 2 inches.

(2) Total Depth 220 feet.


(3) Water Level 170 1/2 feet below top of ground.

(4) Cased to _____, Size _____

(5) Screen: Size 2 in., Length 10

(6) Were any formations sealed against pollution?
_____ yes, _____ no.

CODED

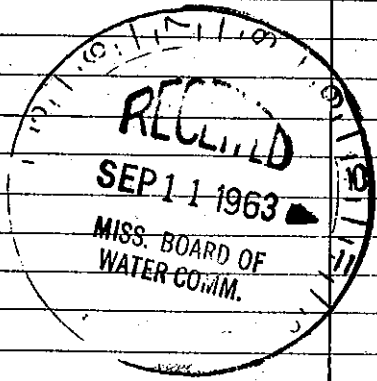

If YES depth of formation _____

Why _____

Drillers Remarks: _____

Well No.

(Use Back Side)

Retain this copy for your office files.