

LAMAR
E 79
11-1-63

MISSISSIPPI BOARD OF WATER COMMISSIONERS

WATER WELL DRILLERS LOG

CODED


Date: 11-1, 1963, Driller: Jay Lett County Lamar

Hattiesburg Butane Gas Co.
(Name)

(1) Owner of Land:	Description & Color of Materials Sand, Clay, Red Clay, Shell, etc.	Thick- ness Feet	Depth Feet
<u>Leon Bryant</u> (Name) <u>Rt 3 Hattiesburg, Miss</u> (Address)	<u>0-8- yellow clay</u>		
...	...		
<u>4</u> miles <u>W</u> (direction) <u>Hattiesburg</u> (Nearest Town)	<u>8-24 Red Clay</u>		
(3) Topography: <u>Hilly</u> (Hilly) (Flat) (Level)	<u>32-45 Red Clay</u>		
(4) Purpose of Well: <u>Domestic</u> (Domestic Irrigation Municipal, Industrial, Other)	<u>45-98 white clay</u>		
	<u>98-116 white sand</u>		

Information upon completion of well:

- (1) Diameter 2 inches.
- (2) Total Depth 116 feet.
- (3) Water Level 88 feet below top of ground.
- (4) Cased to _____, Size _____.
- (5) Screen: Size 2", Length 10ft.
- (6) Were any formations sealed against pollution?
_____ yes, _____ no.

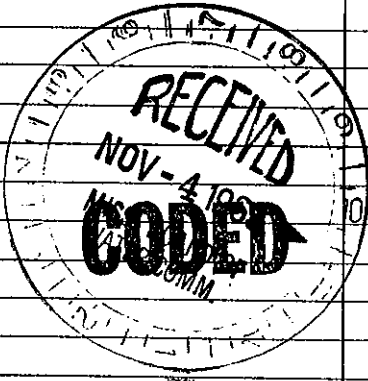

If YES depth of formation _____

Why _____

Drillers Remarks: _____

Well No. _____

(Use Back Side)