

LAMAR MISSISSIPPI BOARD OF WATER COMMISSIONERS

E80

1-21-61

WATER WELL DRILLERS LOG

Date: 1-21, 1961, Driller: Hermon Parker County: Lamar

(Name)

(1) Owner of Land: <u>W. W. ROBERTS</u> (Name)	Description & Color of Materials Sand, Clay, Red Clay, Shell, etc.	Thick- ness Feet	Depth Feet
<u>ROUTED 6-HATTIESBURG MISS</u> <u>RFD 3</u> (Address)	<u>Blue CHALK</u>	<u>257</u>	<u>257</u>
(2) Location: <u>1/4</u> , <u>1/4</u> , Sec. <u> </u> T. <u> </u> R. <u> </u>	<u>SAND</u>	<u>43</u>	<u>43</u>
<u>8</u> miles <u>SOUTH-W</u> of <u>HATTIESBURG</u> (distance) (direction) (Nearest Town)		<u>300</u>	<u>300</u>
(3) Topography: <u>Hilly</u> (Hilly) (Flat) (Level)			
(4) Purpose of Well: <u>DOMESTIC</u> (Domestic Irrigation Municipal, Industrial, Other)			


Information upon completion of well:

- (1) Diameter 2 inches.
- (2) Total Depth 300 feet.
- (3) Water Level 123 feet below top of ground.
- (4) Cased to 300, Size 2"
- (5) Screen: Size 2", Length 5'
- (6) Were any formations sealed against pollution?
no yes, no no.

If YES depth of formation _____

Why _____

Drillers Remarks: _____

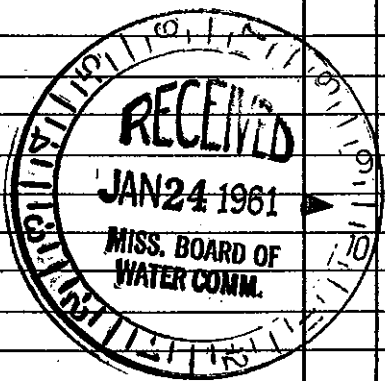

(Use Back Side)

Well No. 12

Mail this copy to Board of Water Commissioners 429 Miss. St. Jackson, Miss.