

LAMAR MISSISSIPPI BOARD OF WATER COMMISSIONERS

E 81

WATER WELL DRILLERS LOG

3-

9-19-63

Date: Sept 17, 1963, Driller: Jay Lott County Lamar

(Name)

(1) Owner of Land:	Description & Color of Materials Sand, Clay, Red Clay, Shell, etc.	Thick- ness Feet	Depth Feet
<u>M. L. Mc Cartey</u> (Name) <u>Rt 4 Hattiesburg, Miss</u> <u>Hwy 98</u> (Address)	<u>1' - 8' Red clay</u>		
(2) Location: <u>1/4</u> , <u>1/4</u> , Sec. <u>   </u> T <u>   </u> R <u>   </u>	<u>8' - 35' gravel</u>		
<u>4</u> miles <u>West</u> of <u>Hattiesburg</u> (distance) (direction) (Nearest Town)	<u>35' - 56' white sand</u>		
(3) Topography: <u>   </u> (Hilly) (Flat) (Level)	<u>56' - 300' blue clay</u>		
(4) Purpose of Well: <u>domestic</u> (Domestic Irrigation Municipal, Industrial, Other)	<u>300 - 338' blue clay</u>		


Information upon completion of well:

- (1) Diameter 2 inches.
- (2) Total Depth 338 feet.
- (3) Water Level 210 feet below top of ground.
- (4) Cased to    , Size    .
- (5) Screen: Size 2 in, Length 10 ft.
- (6) Were any formations sealed against pollution?  
    yes,     no.

If YES depth of formation    

Why    

Drillers Remarks:    

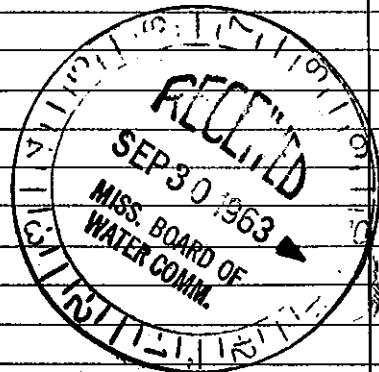

(Use Back Side)

Well No.

Mail this copy to Board of Water Commissioners 429 Miss. St. Jackson, Miss.