

CODED

LAMAR
E
2-68
MISS GEO. SURVEY

MISSISSIPPI
BOARD OF WATER COMMISSIONERS
416 North State Street
Jackson, Mississippi 39201

E82

WATER WELL DRILLERS LOG

FEB. 27th 1968 - BARNCO DRILLING CO. INC. LAMAR
date well completed firm name county well located

LANDOWNER:
ARNOLD LINC WATER ASSO.
RT 4 - HATTIESBURG, MISS.
(mailing address)


description of formations encountered	from	to
TOP SOIL	0	10
Blue SHALE	10	218
SAND	218	294
SHALE	294	310
SAND	310	516
SHALE	516	696
SAND	696	810

WELL LOCATION:
sec. 2 T. 4 N R. 14 W
S W

WELL PURPOSE: MUNICIPAL
(home, irrigation, municipal, industrial)

- WELL COMPLETION DATA:
- (1) diameter (inches) 8 5/8"
 - (2) total depth (feet) 810
 - (3) static water level (feet) 96 below above top of ground.
 - (4) casing Steel 727
(material) (depth)
8 5/8
(size) If telescope see back.
 - (5) screen 50' 696
(length) (depth to top)
6" Stainless Steel
(size) (material)
 - (6) pump 15 150
(HP) (yield gpm)
Elec.
(type power)
 - (7) electric log yes
(yes or no)
Miss Geo. Survey
(organization running log)
 - (8) how well bottom plugged BACK WASH
VALVE

CODED

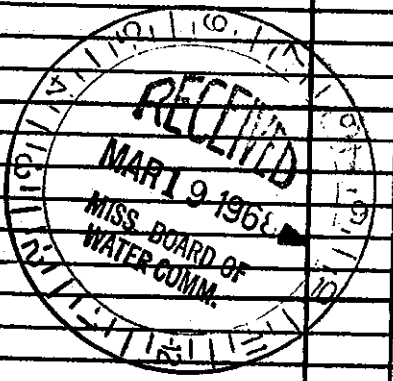

DRILLERS REMARKS: