

Lamar
E012
10-14-68

MISSISSIPPI
BOARD OF WATER COMMISSIONERS
416 North State Street
Jackson, Mississippi 39201

CODED

WATER WELL DRILLERS LOG

10/14 1968 date well completed
S & H firm name
Lamar county well located

LANDOWNER: <u>W B McDonald</u>	description of formations encountered	from	to
<u>pt 4</u> <u>Hattiesburg, Miss.</u> (mailing address)			
	<u>clay</u>	<u>0</u>	<u>30</u>
	<u>gravel</u>	<u>30</u>	<u>40</u>
	<u>OWB Sand</u>	<u>40</u>	<u>50</u>


WELL LOCATION:
sec 23 T 4 N R 14 E
S W
4 miles SW of Hattiesburg
(distance) (direction) (nearest town)

WELL PURPOSE: Home
(home, irrigation, municipal, industrial)

- WELL COMPLETION DATA:
- (1) diameter (inches) 2"
 - (2) total depth (feet) 50
 - (3) static water level (feet) 28 below above top of ground.
 - (4) casing plastic, 45'
(material) (depth)
2" If telescope see back.
(size)
 - (5) screen 5 ft, 45'
(length) (depth to top)
2" plastic
(size) (material)
 - (6) pump 1/2 800 G.P.M.
(HP) (yield gpm)
Jet
(type power)
 - (7) electric log
(yes or no)

(organization running log)
 - (8) how well bottom plugged value

CODED

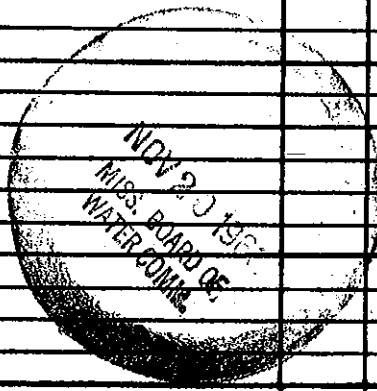

DRILLERS REMARKS: