

Lamar  
E 93  
10-15-68

MISSISSIPPI  
BOARD OF WATER COMMISSIONERS  
416 North State Street  
Jackson, Mississippi 39201

CODED

WATER WELL DRILLERS LOG

10/15 1968 S+R Lamar  
date well completed firm name county well located

LANDOWNER: Frank Parin  
Rt 4  
Hethers Min.  
(mailing address)

| description of formations encountered | from | to  |
|---------------------------------------|------|-----|
| Clay                                  | 0    | 40  |
| Fine Sand                             | 40   | 60  |
| Gravel                                | 60   | 70  |
| Sandy Clay                            | 70   | 90  |
| Fine Sand                             | 90   | 100 |
| CW B Sand                             | 100  | 115 |


WELL LOCATION:  
sec 30 T. 4 N R. 14 E  
S W  
9 miles SW of H. Bay  
(distance) (direction) (nearest town)

WELL PURPOSE: Home  
(home, irrigation, municipal, industrial)

WELL COMPLETION DATA:

- (1) diameter (inches) 2"
- (2) total depth (feet) 115
- (3) static water level (feet) 20 below top of ground
- (4) casing plastic, 110 (material) (depth)  
2" (size) if telescope see back.
- (5) screen 5 ft, 110 (length) (depth to top)  
2" plastic (size) (material)
- (6) pump 1 (HP) 650 gpm (type power)
- (7) electric log (yes or no)
- (organization running log)
- (8) how well bottom plugged Valve

CODED

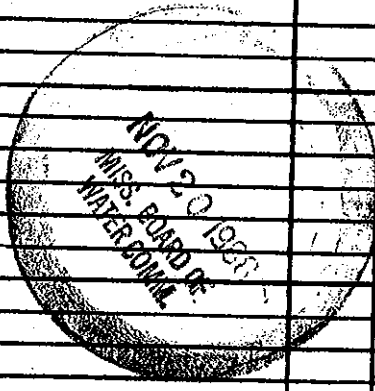

DRILLERS REMARKS: