

Lamar
E 94
8-9-68

MISSISSIPPI
BOARD OF WATER COMMISSIONERS
416 North State Street
Jackson, Mississippi 39201

CODED

WATER WELL DRILLERS LOG

8/9 19 68 S & R Lamar
date well completed firm name county well located

LANDOWNER: Mr. John Smith

description of formations encountered	from	to
---------------------------------------	------	----

Hathaway, Miss.
(mailing address)

Clas	0	20
Fine Sand	20	30
Gravel + Sand	30	42
Clas	42	50
Fine Sand	50	70
Striped Sand	70	80
Fine Sand	80	100
CWB Sand	100	130


WELL LOCATION:
sec. 20 T 4 N R 14 E
S W
7 miles W of H. Bay
(distance) (direction) (nearest town)

WELL PURPOSE: Home
(home, irrigation, municipal, industrial)

WELL COMPLETION DATA:

- (1) diameter (inches) 4"
- (2) total depth (feet) 130
- (3) static water level (feet) 42 below top of ground
- (4) casing 1 1/2" (material) 125' (depth)
4" (size) if telescope see back.
- (5) screen 5 ft 1 1/2" (length) (depth to top)
4" (size) plastic (material)
- (6) pump 1/3 (HP) 900 gpm. (yield gpm)
Sub (type power)
- (7) electric log (yes or no)
- (organization running log)
- (8) how well bottom plugged Valve

CODED

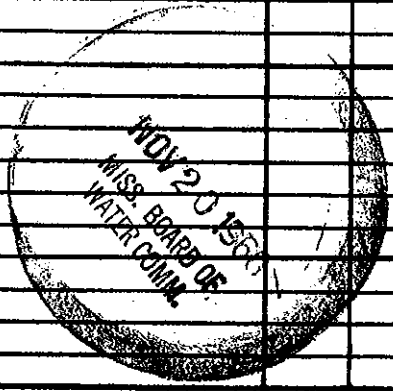

DRILLERS REMARKS: