

Lamar
E 95
8-6-68

MISSISSIPPI
BOARD OF WATER COMMISSIONERS
416 North State Street
Jackson, Mississippi 39201

CODED

WATER WELL DRILLERS LOG


8/6 1968 SFR
date well completed firm name county well located

LANDOWNER: <u>M C Williams</u>	description of formations encountered	from	to
<u>Hunterby, Miss</u> (mailing address)			
	<u>Clay</u>	<u>0</u>	<u>20</u>
	<u>Sandy Clay</u>	<u>20</u>	<u>30</u>
	<u>Top Shell</u>	<u>30</u>	<u>60</u>
	<u>CR Sand</u>	<u>60</u>	<u>75</u>

WELL LOCATION:
sec. 20 T. 4 N. R. 14 E.
S W
7 miles W of H. Big
(distance) (direction) (nearest town)

WELL PURPOSE: Home
(home, irrigation, municipal, industrial)

- WELL COMPLETION DATA:
- (1) diameter (inches) 4"
 - (2) total depth (feet) 75 ft
 - (3) static water level (feet) 34 below above top of ground
 - (4) casing plastic 70
(material) (depth)
4" if telescope see back.
(size)
 - (5) screen 5 ft 70 ft
(length) (depth to top)
4" (material)
(size)
 - (6) pump 1/2 1200 ft.
(HP) (yield gpm)
Sub.
(type power) 60
 - (7) electric log yes or no
(organization running log)
 - (8) how well bottom plugged

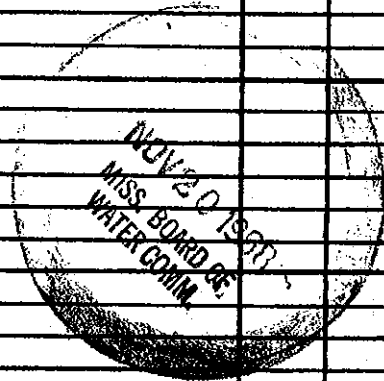

DRILLERS REMARKS: