

Lamar
E 96
8-13-68


MISSISSIPPI
BOARD OF WATER COMMISSIONERS
416 North State Street
Jackson, Mississippi 39201

CODED

WATER WELL DRILLERS LOG

8/13 1968 date well completed
STRC firm name
Lamar county well located

LANDOWNER: <u>Ray Force</u>	description of formations encountered	from	to
<u>Bathubey Miss.</u> (mailing address)	<u>Clay</u>	<u>0</u>	<u>10</u>
	<u>fine sand</u>	<u>10</u>	<u>20</u>
	<u>sandy gravel</u>	<u>20</u>	<u>30</u>
	<u>big gravel</u>	<u>30</u>	<u>40</u>
	<u>PS & sand</u>	<u>40</u>	<u>60</u>
WELL LOCATION: sec. <u>8</u> T. <u>N</u> R. <u>14</u> E <u>S</u> <u>W</u> <u>7</u> miles <u>W</u> of <u>H Bay</u> (distance) (direction) (nearest town)			
WELL PURPOSE: <u>Home</u> (home, irrigation, municipal, industrial)			
WELL COMPLETION DATA:			
(1) diameter (inches) <u>4"</u>			
(2) total depth (feet) <u>60 ft</u>			
(3) static water level (feet) <u>34</u> below above top of ground.			
(4) casing <u>Plastic</u> <u>55'</u> (material) (depth)			
<u>4"</u> If telescope see back. (size)			
(5) screen <u>5'</u> <u>55 ft</u> (length) (depth to top)			
<u>4"</u> <u>plastic</u> (size) (material)			
(6) pump <u>1/2</u> <u>700 gpm</u> (HP) (yield gpm)			
<u>Sub</u> (type power)			
(7) electric log _____ (yes or no)			
_____ (organization running log)			
(8) how well bottom plugged <u>Value</u>			

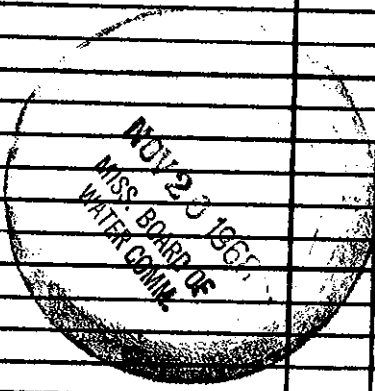

DRILLERS REMARKS: