

LAMAR MISSISSIPPI BOARD OF WATER COMMISSIONERS

CODED

WATER WELL DRILLERS LOG

E 140
3-13-62

Date: 3-13, 1962, Driller: Leo Lachar County: Lamar
(Name)

(1) Owner of Land: H D Evans
(Name)
Purvis Miss
(Address)

(2) Location: 1/4, 1/4, Sec. 32 T4R14,
12 miles North of Purvis
(distance) (direction) (Nearest Town)

(3) Topography: V
(Hilly) (Flat) (Level)

(4) Purpose of Well: Home
(Domestic Irrigation
Municipal, Industrial, Other)

Description & Color of Materials Sand, Clay, Red Clay, Shell, etc.	Thick- ness Feet	Depth Feet
<u>Clay</u>	<u>32</u>	<u>0-32</u>
<u>Sand & Shale</u>	<u>46</u>	<u>32-76</u>

Information upon completion of well:

(1) Diameter: 2 inches.

(2) Total Depth: 76 feet.

(3) Water Level: 35 feet below top of ground.

(4) Cased to: 71, Size 2

(5) Screen: Size 10/16, Length 5


(6) Were any formations sealed against pollution?
yes, no.

CODED

If YES depth of formation _____

Why _____

Drillers Remarks: _____

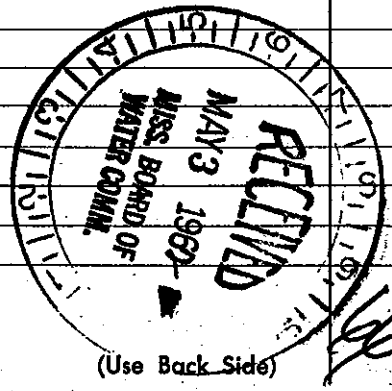

Well No. _____

Mail this copy to Board of Water Commissioners 429 Miss. St. Jackson, Miss.