

LAMAR

E 190

Lake Forest

1-18-74

MISSISSIPPI BOARD OF WATER COMMISSIONERS CODED
416 North State Street
Jackson, Mississippi 39201

WATER WELL DRILLERS LOG

1-18-74 date well completed
1974 Rural Drilling & Lamar firm name
county well located

LANDOWNER: Ralph Carnie

R.F.D. 4
Hattiesburg Miss.
(mailing address)

description of formations encountered	from	to
Sandy clay	0	18
clay sand	18	26
stratified clay	26	35
Fine sand	35	54
Co. sandstone	54	70


WELL LOCATION:
sec. 4 T 4 N R 14 E
S W
5 miles W of Hattiesburg
(distance) (direction) (nearest town)

WELL PURPOSE: Home
(home, irrigation, municipal, industrial)

WELL COMPLETION DATA:

- (1) diameter (inches) 4"
- (2) total depth (feet) 70 ft
- (3) static water level (feet) 25 ft below top of ground
- (4) casing (material) Plastic, 60 ft (depth)
4" (size) if telescope see back.
- (5) screen 10 ft - 70 ft (length) (depth to top)
4" (size) Plastic (material)
- (6) pump 1/2 HP (900 gpm) (yield gpm)
Sub (type power)
- (7) electric log (yes or no)
- (organization running log)
- (8) how well bottom plugged Valve

DRILLERS REMARKS:

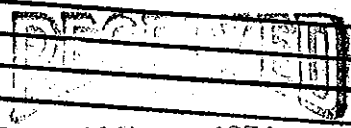

JAN 28 1974

MISS. BD. OF WATER COMM.