

**MISSISSIPPI DEPARTMENT OF ENVIRONMENTAL QUALITY**

Office of Land and Water Resources

P. O. Box 10631  
Jackson, MS 39289-0631  
**WATER WELL DRILLERS LOG**

COUNTY WELL LOCATED  
Ramar

WELL NUMBER E234 CODED

DATE WELL COMPLETED  
5-29-95

PERMIT NUMBER \_\_\_\_\_

NAME OF DRILLING FIRM  
Boone's Water Well

NAME & MAILING ADDRESS OF LANDOWNER  
Bill Bramblett

275 Sandy Run Rd.

Wattiburg

WELL LOCATION: SEC 23 TOWNSHIP 4 RANGE 14 N S W

DISTANCE 2 Miles S of Wattiburg

OTHER LANDMARK \_\_\_\_\_

WELL PURPOSE: Home, Irrigation, Municipal, Industrial, Fish Pond, etc.  
Trailer Park

**PUMP DATA**

PUMP TYPE (Circle One):  
Submersible, Turbine, Jet, Flowing Well,  
Other (Describe) \_\_\_\_\_

POWER TYPE (Circle One):  
Electric, Tractor, Diesel, Gasoline, 5 Butane,  
Other (Describe) \_\_\_\_\_ H/P 5

Pump Capacity (GPM) 50 No. of Stages \_\_\_\_\_ Setting Depth 265 FT.

PUMP TEST

Well yielded 50 GPM with  
a drawdown of 12 ft.  
after 48 hours of pumping

**WELL DATA**

Well Depth <u>285</u>	Casing Diameter (In.) <u>4</u>	Casing Length (Ft.) <u>255</u>
Type of Casing <u>40</u>	Hole Depth <u>285</u>	Depth to Static Water Level <u>240</u>

TYPE OF COMPLETION: (Circle One or More):  
Gravel Packed, Underreamed, Telescoped,  
Natural Development, Open Hole, Other  
(Describe) \_\_\_\_\_

WELL GROUTED TO A DEPTH OF 6 FEET  
Type Grout (circle one) Cement, Bentonite, or Mix

**LOG DATA**

TYPE OF LOG RUN (Circle One):  
No Log Run, Electric, Gamma Ray, Density, Sonic, Neutron,  
Other (Describe) \_\_\_\_\_

Name of Organization Running Log \_\_\_\_\_

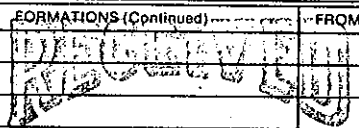
**SCREEN DATA**

Diameter - Inches <u>4</u>	Length - Feet <u>30</u>	Slot Size - Inches <u>8</u>
Screen Type <u>Deh 40</u>	Depth to Bottom - Feet	

**GEOLOGIC DATA (Office Use Only)**

Surface Elev.	Geologic Unit	Unit Thickness	Depth to Top
Subs. SWL	Date	Analysis	Aquifer Test

Driller's Remarks \_\_\_\_\_

DESCRIPTION OF FORMATIONS ENCOUNTERED	FROM	TO	FORMATIONS (Continued)	FROM	TO
<u>Clay</u>	<u>0</u>	<u>50</u>	 JAN 29 1995		
<u>Sand</u>	<u>50</u>	<u>80</u>			
<u>Clay</u>	<u>80</u>	<u>170</u>			
<u>Sand</u>	<u>170</u>	<u>285</u>			

Dept. of Environmental Quality  
Office of Land & Water Resources

IF MORE SPACE IS NEEDED, USE BACK