	ell Report	For Office Use Only:			
County: County	<b>Driller's Log</b> at of Environmental Quality	Aquifer. <u>F 298</u>			
Permit #: 0-586 Office of Land a	nd Water R <b>eseurces</b> Box 2309	Well #:			
Driller: JAMES WELLS Jackson	n, MS 39225	L. S. Elcvation:			
	961- 5210 1- 5228 (fax)	E-log #:			
	E-10				
State Law requires that this report be prepared by the lic Department at the above address within 30 days of comp	ense notaer responsible for pletion of drilling of the well	l or borehole.			
Information on Well Owner	Weil or Bo	orehole Location			
(Landowner if borehole is not for a water well)	Latitude: 31. 17,	$\frac{5}{27} \text{ Longitude: } \frac{79}{23} \cdot \frac{27}{27}$			
Owner Name Kandy Smith Mailing Address: 321 Steelman Rd.	Method of Lat/Long (circle o	ne): Conventional Survey,			
Mailing Address: 321 Steel Man Kd.	USGS quad, Hand-held	I GPS, Survey-grade GPS			
11.11	54 1/4 5K 1/4 Sec 2:	$3_{\text{Twn}} 4N_{\text{Rng}} 4W$			
Hatties burg 115 37402	Hatties 11/2 27902 INF NW 27				
	Distance Direction	of Oakgrove			
Telephone No. (601) 296 - 0391	x				
Well / Bore		-1/11			
Date drilling started: $2 - 9 - 11$ Date drilling completed: $2 - 9 - 11$	Date drilling started: 2-9-11 Date drilling completed: 2-9-11 Hole depth: 210 Hole diameter. 71/2"				
Location of the source of any surface water used for drilling:	omnius ty				
Withing of dosing and totalis of another set	•				
Logs run (circle all applicable): No log run Electric Gamma Ray Name of organization running log(s):	Density Sonic Neutron	Other:			
Purpose of borehole (check one): Water Well Ceotechnical/Geol	ogical Investigation Ground	d Source Heat Pump			
Seismic Survey Other (describe)					
Purpose of Well (check one): Home Industrial Public Supply					
If a flowing well, method of flow regulation: Valve Other (describe)					
Static Water Level:					
Method of Measurement (circle one) steel tape electric tape	air line other.				
Well depth: <u>210</u> Well grouted to a depth of <u>10</u> feet Type	e of grout (circle one): (Neat Cen	nent) Bentonite Mix			
Casing length: <u>190</u> feet Casing diameter: <u>4</u> inches Type of casing: <u>PVC</u>					
Screen length: <u>D</u> feet Screen diameter: <u>4</u> inches Type of screen: <u>PVC</u>					
Screen slot size:					
Type of completion (circle all applicable): Gravel packed Under	rreamed Telescoped Oper	n hole Natural Development			
Other (describe):					
Top of lap pipe or reduction in casing:feet. If te	lescoped or more than one scre	een, describe on next page			
		Form: OLWR-SWR-1A (04/08)			
	f	RECEIVED			
	1	MAR 1 1 2011			

٣

د. بر

.

BY: OLWR


## The sketch below only required for water wells

If well telescopes, show depths on sketch. Ground Level\_\_\_\_\_

Description of formations encountered must	<u>t be provided for all</u>
wells and boreholes, unless specifically exen	npted by regulations

Description of Formations Encountered	From (depth) Ground Level	
Clay	1	53
sand	50	65
day		15
sand'	150	21
		L
		ļ
· · · · · · · · · · · · · · · · · · ·		<u> </u>
		<b>_</b>
		<b></b>
		<u></u>
		ļ
		<u> </u>
·		L
	1	1

If more than one screen, show location of each on sketch

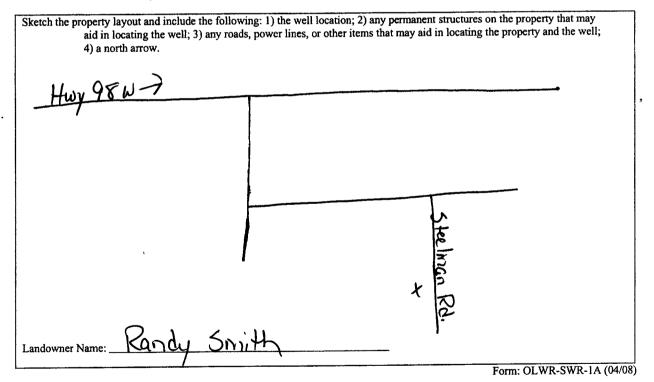

I certify that the well/borehole was drilled, constructed, and completed in accordance with all applicable requirements of the Mississippi Department of Environmental Quality and the Mississippi Department of Health regulations, if applicable, and state

JAMES WELLS 0-586

Print Name of Responsible Licensee and License No.

Date

James Walls Signature of Licen RECEIVED

MAR 1 1 2011 BY: OLWR

-	STATE WELL	REPORT		
	Part 2		For Office Use Only:	
County: Lamar	Pump Installer's Completion Report Mississippi Department of Environmental Quality Office of Land and Water Resources P.O. Box 10631			
			Aquifer: 	
Permit #:				
Driller JAMES WELLS		Jackson, MS 39289-0631		
Date completed: 2-9-11	(601)961-5 (601)354-693		Elevatica:	
			nt silenta Rie Gerra of the	
This report should be prepared by	the pump installer in detail and			
installation of pump. Well Owner Inform	nation	We	H Locality	
Dood So	11 1	itude:	_Longitude:	
C Treade a commentation			ne): Conventional Survey,	
Mailing Address: 32 Stee	man Rd. Me			
		USGS quad, Han	d-held GPS, Survey-grade GPS	
1/41/201	ms 39412	1/4 Sec 0	23 Twn 4N Rog 14R	
Hattiesburg sta			·	
	Dis	tance Direction		
Telephone No. (10) 296-0	39/	<u>3_Miles_t</u>	of Oakgrove	
		·····		
Ригар Туре	.		ower Type	
Circle one			Circle one	
Air Lift Jet	Submersible Die	sei Engine Gasol	ine Engine Natural Gas	
Bucket Piston	Turbine Ele	ctric Motor Hand		
Centrifugal Rotary			r (specify):	
Cenunugar	u u	ree Power Rating of Mot	or 1/2	
Other (specify):		157		
Date Pump Installed:	Se	tting Depth:IOO	1	
Rated Pump Capacity:9	Gallons Per Minute Nt	mber of Stages:		
Kaist I unit Columny				
Pump Test D	ata	Method of M	leasuring Water Level	
2011			Circle one	
Date Well Tested: $Q = 7 = 1/$		r Line Electric M	easuring Line Steel Tapa	
Static Water Level (A): 90	Feet Below Land Surface	ther (specify):		
	Feet Below Land Surface	une (spours).		
		r flowing well, measured	shut in head:fee	
Drawdown [(B) - (A)]: 7 0		27	GPM with a drawdown of	
Test Pumping Rate:	Gallons Per Minute - W	ell yielded/	-11	
	hours). 4 hours	feet after	hours of pumpin	
Duration of Pump Test (minimum 4 ho	······			
I HEREBY CERTIFY that the above s	statements are true to the best of m	y knowledge.	11.11.	
	0-586	I WYV	o werro	
JAMES WELLS Print Name of Pump Installer and Lice		Signature of Pump	Installer	
I THE TANK VI LUMP HOMAN AND AND		חרי	EIVED	
		KEU		
			1 4 9011	
		-	1 1 2011	
		DV	OLWR	
		DY.		