County: <u>Lamas</u> Permit #: <u>Driller: James M. Wells</u> Date drilling completed: <u>12-22-15</u> Jacks	WELL REPORT Part 1 priller's Log ment of Environmental Quality nd and Water Resources 2.0. Box 2309 bon, MS 39225-2309 601)961-5210 1)360-0535 (fax) license holder responsible for the mpletion of drilling of the well of Difference Solution Bore Latitude: 31 13, 252 Long	or borehole. hole Location
Mailing Address: <u>778 Prospres Ridge Rd.</u> <u>Columbia M5 39429</u> <u>City State Zip Code</u> <u>Telephone No. (GD1) G06-1157</u>	USGS quad, Hand-held Gi	18 T 3N R/GW
Date drilling started: 12-22-15 Date drilling completed: Location of the source of any surface water used for drillin Method of dosing and volume of Chlorine used in drilling an Logs run (circle all applicable) No log run Electric Gamm Name of organization running log(s): Purpose of borehole (circle one): Water Well Geotechnic	g: <u>Funning Creek</u> d development: <u>granul</u> a Ray Density Sonic Neutron al/Geological Investigation G	Other:
Purpose of Well (circle all applicable): Home Industrial Other (describe):	Public Supply Irrigation Fig Other ( <i>describe</i> ) and surface Date measured: pe Air line Other ( <i>describe</i> ): t Type of grout ( <i>circle one</i> ): inches Type of case inches Type of scr	eat Cement Bentonite Mix
Top of lap pipe or reduction in casing:feet If telescoped or more than one	SCREEN, describe on next page	

• >

#7

Form: OLWR-SWR-1A (4/13)


County:	Lamor
---------	-------

Permit #: \_

## For Office Use Only: well #: FICC

## The sketch below only required for water wells

## Description of formations encountered must be provided for all wells and boreholes, unless specifically exempted by regulations

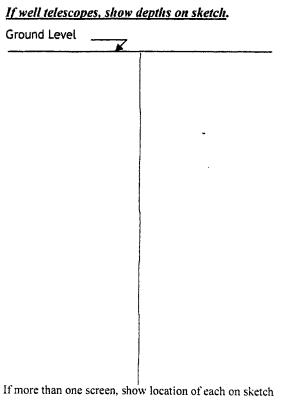

Description of Formations Encountered	From (depth) Ground level	To (depth)
topsvil	Ground level	1
Clay	1	70
Sand	70	115
	+	
	1	
	1	
	1	
· · · · · · · · · · · · · · · · · · ·		

Sketch the property layout and include the following:	
1) the well location	
2) any permanent structures on the property that may aid in locating the well	
3) any roads, power lines, or other items that may aid in locating the property and the well	
4) north arrow	
+wy 98	
Baylis Chapel Rd	
10 Bayles a character	
C C C C C C C C C C C C C C C C C C C	
in the second seco	
	FEB Q 3 2608
V El	<ul> <li>Login Cold</li> <li>Part of the second se</li></ul>
	n (1997) 1. state (1997) 1. s
	·
Landowner Name: Orrin Thornhill	
I HEREBY CERTIFY that the well/borehole was drilled, constructed, and completed in accordance	e with all applicable
requirements of the Mississippi Department of Environmental Quality and the Mississippi Department of applicable, and state laws.	nent of Health regulations,
Toma in valle ANDERED 13111	
James M. Wells 00005889 1-31-16 James ~	· (melle
Print Name of Responsible Licensee and License No. Date Signature	of Licensee

Form: OLWR-SWR-1A (4/13)

	STATE W	ELL REPORT				
County: Laman	1	Part 2	For Office Use Only:			
Permit #:	Pump Installe	er's Completion Report nent of Environmental Quality	Well #: FICC			
Driller: James M. Wells	Office of La	nd and Water Resources	Weit #			
Date completed: 12.22-15	1 · · · · · · · · · · · · · · · · · · ·	.O. Box 2309	Aquifer:			
Copy information from block on Part 1						
This part of the report must be complete of the report must be attached and both	ed by a licensed wate	r well contractor or a licensed put	mp installer. A copy of Part 1 vithin 30 days of well completion			
Well Owner Information Well Location						
Owner Name: Orrin Tho	cohill	Latitude: 31 13.252 Lor	ngitude: 087 39,132			
Mailing Address:		Method of Lat/Long (check one	): Conventional Survey,			
778 Prospres Riv	deo Rd.		PS, Survey-grade GPS			
<u>Ciliabio</u>	394.20		18 T 3N R 16W			
<u>Columbia</u> <u>MS</u> City State	Zip Code	1				
Telephone No. (1001) 606-115	57	$\frac{16}{(Distance)} \text{ Miles } \underbrace{E}_{(Direction)} \text{ Direction}$	(Nearest Town)			
	Pump Ty	pe (circle one)				
Submersible Turbine Air Lift Centri		<u> </u>				
Date Pump Installed: 12-22-15	5	Rated Pump Capacity:	Gallons Per Minut			
Is This Pump (circle one): New Re						
		rpe (circle one)				
Electric Diesel Gasoline Natural Ga	s Tractor PTO Wi	ndmill Other (describe):				
Horse Power Rating of Motor:3	Setting Dep	th: <u>110</u> feet Number	of Stages:			
	-	for Non Flowing Well	21			
Date Well Tested:	-		num 4 hours): hour			
Static Water Level (A): Fee		Pumping Water Level (B):	10 Feet Below Land Surface			
Drawdown [(B) - (A)]:	_Feet Below Land Sur	face Test Pumping Rate:	35 Gallons Per Minute			
Method of measurement (circle one):						
	Pump Test Da	ata for Flowing Well				
Measured shut in head:fee	t.					
Well yieldedGPM with a	drawdown of	feet_after	hours of pumping			
		Installation				
Meter Manufacturer:		Meter Serial Number:				
Meter Model Number/Name:		Type of Meter:	. <u> </u>			
Totalizer Register Unit and Multiplier F	actor (AF x .001, ga	l x 1000, etc):				
Installation Date: Meter installed by:						
is This Meter (circle one): New Re	paired Replacem	ent	FEB Q 注意:			
Important: By submitting the above information you are certifying that this meter was installed to manufacturer standards. For agricultural wells, a list of approved meters is on the MDEQ website.						
I HEREBY CERTIFY that the above state	ments are true to the	e best of my knowledge.	÷ بې د بې			
James M. Wells 0000.	Tames M. Wells 00005889 1-31-16 James M. Conf. 2 Print Name of Pump Installer and License No. ( <i>if applicable</i> ) Date Signature of Pump Installer					
Print Name of Pump Installer and Licer	ise NO. (If applicable	e) Date Signa	ature of Pump Installer			

• • • •

#2