

MISSISSIPPI DEPARTMENT OF NATURAL RESOURCES

Bureau of Land and Water Resources

COUNTY WELL LOCATED <u>Lamar</u>	
WELL NUMBER <u>F 2129</u>	CODED
DATE WELL COMPLETED <u>6-28-89</u>	

PERMIT NUMBER
NAME OF DRILLING FIRM <u>Bones W/W</u>

P.O. Box 10631
Jackson, Mississippi 39209
WATER WELL DRILLERS LOG

NAME & MAILING ADDRESS OF LANDOWNER <u>Mennis Moar</u>			
WELL LOCATION: SEC <u>3</u> TOWNSHIP <u>3</u> RANGE <u>16</u>			
DISTANCE <u>7</u> Miles		DIRECTION <u>SW</u> of NEAREST TOWN <u>Bellave</u>	
OTHER LANDMARK			
WELL PURPOSE <input checked="" type="checkbox"/> Home Irrigation, Municipal, Industrial, Fish Pond, etc.			

PUMP DATA		
PUMP TYPE (Circle One): Submersible, Turbine, <input checked="" type="radio"/> Jet, Flowing Well, Other (Describe) _____		
POWER TYPE (Circle One): <input checked="" type="radio"/> Electric, Tractor, Diesel, Gasoline, Butane, Other (Describe) _____ H/P <u>1</u>		
Pump Capacity (GPM) <u>3 1/2</u>	No. of Stages <u>2</u>	Setting Depth <u>40</u> FT.
PUMP TEST		
Well yielded _____ GPM with a drawdown of _____ ft. after _____ hours of pumping		

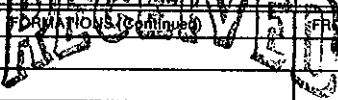
WELL DATA		
Well Depth <u>52</u>	Casing Diameter (In.) <u>2</u>	Casing Length (Ft.) <u>42</u>
Type of Casing <u>sch 40</u>	Hole Depth <u>52</u>	Depth to Static Water Level <u>36</u>
TYPE OF COMPLETION: (Circle One or More): <input checked="" type="checkbox"/> Gravel Packed, Underreamed, Telescoped, Natural Development, Open Hole, Other (Describe) _____		
Top of Lap Pipe or Reduction in Casing FEET <input type="checkbox"/> IF TELESCOPED OR MORE THAN ONE SCREEN: USE BACK PAGE		

LOG DATA	
TYPE OF LOG RUN (Circle One): Electric, Gamma Ray, Density, Sonic, Neutron, Other (Describe) _____ No Log Run	
Name of Organization Running Log	

GEOLOGIC DATA (Office Use Only)			
Surface Elev.	Geologic Unit	Unit Thickness	Depth to Top
Subs. SWL	Date	Analysis	Aquifer Test

SCREEN DATA		
Diameter - Inches <u>2</u>	Length - Feet <u>10</u>	Sigt Size - Inches <u>10</u>
Screen Type <u>sch 40</u>	Depth to Bottom - Feet <u>52</u>	

Driller's Remarks

DESCRIPTION OF FORMATIONS ENCOUNTERED	FROM	TO	DESCRIPTIONS (continued)	FROM	TO
<u>Sandy Clay</u>	<u>0</u>	<u>22</u>			
<u>Sand</u>	<u>22</u>	<u>52</u>			
			 <u>JUL 31 1989</u>		
			Department of Natural Resources Bureau of Land & Water Resources		
IF MORE SPACE IS NEEDED, USE BACK					