

LAMAR MISSISSIPPI BOARD OF WATER COMMISSIONERS

G63  
4-5-66

S + R Drilling  
WATER WELL DRILLERS LOG

Date: 4-5, 1966, Driller: Gene County Lamar  
(Name)


(1) Owner of Land: Mr. Beal  
(Name)  
PT 3 Small  
(Address)  
(2) Location: 1/4, 1/4, Sec. 3 T. 3 R. 15  
18 miles SW, of Wattisburg  
(distance) (direction) (Nearest Town)  
(3) Topography: Hilly  
(Hilly) (Flat) (Level)  
(4) Purpose of Well: Home  
(Domestic Irrigation  
Municipal, Industrial, Other)

Description & Color of Materials Sand, Clay, Red Clay, Shell, etc.	Thick- ness Feet	Depth Feet
Red Clay	10	10
White Fine Sand	12	22
White Clay	16	38
Pink Clay + Sand	12	50
Sand Rock	1	51
White Sand + Clay stuff	14	65
good white sand	20	85

Information upon completion of well:

(1) Diameter 2' inches.  
(2) Total Depth 85 feet.  
(3) Water Level 40 feet below top of ground.  
(4) Cased to 80, Size 2"  
(5) Screen: Size 2", Length 5'  
(6) Were any formations sealed against pollution?  
\_\_\_\_\_ yes,  no.

If YES depth of formation \_\_\_\_\_  
Why \_\_\_\_\_  
Drillers Remarks: \_\_\_\_\_

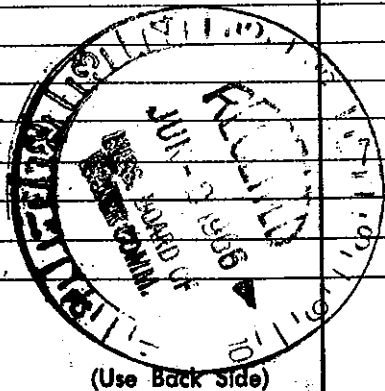

(Use Back Side)

Well No. 14

This copy to Board of Water Commissioners 429 Miss. St. Jackson. Miss.