

MISSISSIPPI DEPARTMENT OF NATURAL RESOURCES

Bureau of Land and Water Resources

Southport Mall

P.O. Box 10631

Jackson, Mississippi 39209

CODED

WATER WELL DRILLERS LOG

Griner Drilling Service, Inc.

Lamar

Lamar
698
7-2-81
7-2-81

date well completed

firm name

county well located

LANDOWNER:

Latham Exploration Co.
Route 700 American Towers
Shreveport, La 71101
(mailing address)

description of formations encountered

from to

<i>chalk</i>	<i>0</i>	<i>130</i>
<i>streaked</i>	<i>130</i>	<i>210</i>
<i>chalk</i>	<i>210</i>	<i>546</i>
<i>streaked</i>	<i>546</i>	<i>567</i>
<i>sand</i>	<i>567</i>	<i>840</i>

WELL LOCATION: *1500 S + 2640 W*


sec. 17 T. 30N R. 15E of
F.M. Tatum Camp
Tatum (nearest town)

WELL PURPOSE: *oil field supply*

WELL COMPLETION DATA:

- (1) diameter (inches) *3"*
- (2) total depth (feet) *840'*
- (3) static water level (feet) *200' below* above top of ground.
- (4) casing *steel 840'*
(material) (depth)
- 3"* if telescope see back.
(size)
- (5) screen *42' 798'*
(length) (depth to top)
- 3" perforated*
(size) (material)
- (6) pump *70*
(HP) (yield gpm)
- ac*
(type power)
- (7) electric log *—*
(yes or no)
- (organization running log)
- (8) how well bottom plugged *range*

CODED

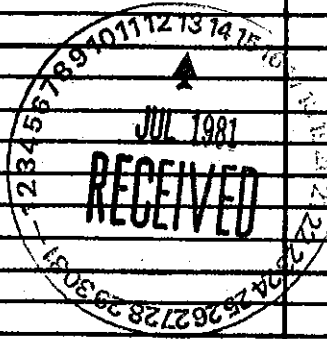

DRILLERS REMARKS:

peel