

LAMAR  
H38

WATER WELL DRILLERS LOG

H-300


Date: 2-27, 1961, Driller: Herman Parks County LAMAR  
(Name)

(1) Owner of Land: <u>L. A. Moss</u> (Name)	Description & Color of Materials Sand, Clay, Red Clay, Shell, etc.	Thick- ness Feet	Depth Feet
<u>Box 657 - Purvis, Miss</u> (Address)	<u>Red CLAY</u>	<u>18</u>	<u>18</u>
	<u>RED SAND</u>	<u>57</u>	<u>75</u>
(2) Location: <u>1/4</u> , <u>1/4</u> , Sec. <u>32</u> T. <u>R.</u> <u>2</u> miles <u>NORTH</u> of <u>PURVIS</u> (distance) (direction) (Nearest Town)			
(3) Topography: <u>Hilly</u> (Hilly) (Flat) (Level)			
(4) Purpose of Well: <u>Domestic</u> (Domestic Irrigation Municipal, Industrial, Other)			

Information upon completion of well:

- (1) Diameter 2 inches.
- (2) Total Depth 75 feet.
- (3) Water Level 38 feet below top of ground.
- (4) Cased to 75, Size 2"
- (5) Screen: Size 2", Length 5'
- (6) Were any formations sealed against pollution?  
no yes, no no.

If YES depth of formation \_\_\_\_\_  
Why \_\_\_\_\_  
Drillers Remarks: \_\_\_\_\_

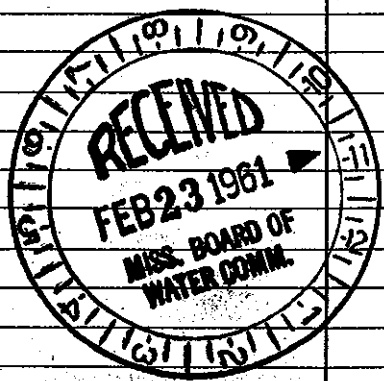

(Use Back Side)

Mail this copy to Board of Water Commissioners 429 Miss. St. Jackson