

LAMAR MISSISSIPPI BOARD OF WATER COMMISSIONERS

H 39
12-22-61

WATER WELL DRILLERS LOG H-4

Date: Dec 22, 1961, Driller: Leo Lusher County Lamar
(Name)

(1) Owner of Land:	Description & Color of Materials Sand, Clay, Red Clay, Shell, etc.	Thick- ness Feet	Depth Feet
TV Lott (Name) Purvis, Miss. (Address)	Sandy clay	8	0-80
(2) Location: 1/4, 1/4, Sec. T R E	Clay	45	8-53
3 miles North of Purvis (distance) (direction) (Nearest Town)	Sand Fine	9	53-62
(3) Topography: <input checked="" type="checkbox"/> (Hilly) <input type="checkbox"/> (Flat) <input type="checkbox"/> (Level)	Clay	40	62-102
(4) Purpose of Well: Home Use (Domestic Irrigation Municipal, Industrial, Other)	Sand	28	102-130


Information upon completion of well:

- (1) Diameter 2 inches.
- (2) Total Depth 130 feet.
- (3) Water level 58 feet below top of ground.
- (4) Cased to 126, Size 2"
- (5) Screen: Size 10/10, Length 4"
- (6) Were any formations sealed against pollution?
 yes, no.

If YES depth of formation _____

Why _____

Drillers Remarks: _____

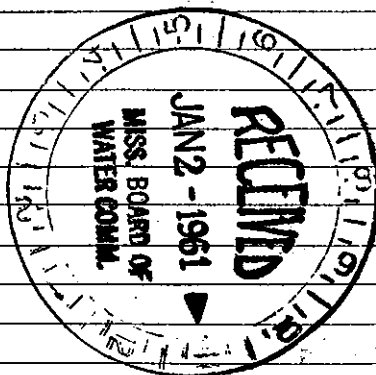

(Use Back Side)

Well No. 53

Mail this copy to Board of Water Commissioners 429 Miss. St. Jackson, Miss