

LAMAR

H 40

WATER WELL DRILLERS LOG

8-10-62

Date: 8-10, 1962, Driller: Hermon Parker County Lamar  
(Name)

(1) Owner of Land:	Description & Color of Materials Sand, Clay, Red Clay, Shell, etc.	Thick- ness Feet	Depth Feet
H. E. Oliver (Name) Rt. 4 Hattiesburg (Address)	red clay sand	30 26	30 56
(2) Location: _____ 1/4, _____ 1/4, Sec. 8 T. R. 7 miles S. West of Hattiesburg (distance) (direction) (Nearest Town)			
(3) Topography: _____ (Hilly) (Flat) (Level)			
(4) Purpose of Well: _____ (Domestic Irrigation Municipal, Industrial, Other)			


Information upon completion of well:

- (1) Diameter 2" inches.
- (2) Total Depth 56 feet.
- (3) Water Level 40 feet below top of ground.
- (4) Cased to 56', Size 2"
- (5) Screen: Size 2", Length 51
- (6) Were any formations sealed against pollution?  
yes,  no.

If YES depth of formation \_\_\_\_\_

Why \_\_\_\_\_

Drillers Remarks: \_\_\_\_\_

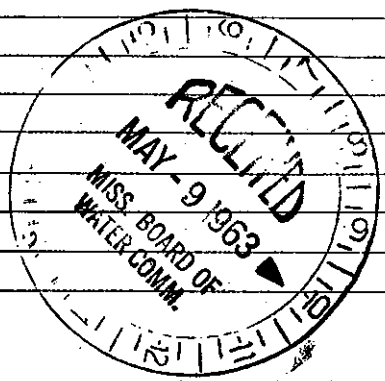

56

50

Well No.

Retain this copy for your office files.