

LAMAR MISSISSIPPI BOARD OF WATER COMMISSIONERS

H 4
3-8-66

WATER WELL DRILLERS LOG

S. H. R. Drilling

Date: 3-31, 1966, Driller: Gene County: Lamar

(Name)

(1) Owner of Land: <u>M. Coyle</u> (Name)	Description & Color of Materials Sand, Clay, Red Clay, Shell, etc.	Thick- ness Feet	Depth Feet
<u>Purvis, Miss</u> (Address)	Red + White Clay	27	27
(2) Location: <u>NE 1/4, SE 1/4, Sec. 14 T. 3. R. 12</u>	Fine White Sand	9	36
+ <u>SE 1/4 H SE 1/4</u>	Brown Clay	34	70
0 miles <u>NE</u> of <u>Purvis</u>	Red Fine Sand	8	78
(3) Topography: <u>Hilly</u>	Blue Clay	45	123
(Hilly) (Flat) (Level)	Strip blue clay sand	29	152
(4) Purpose of Well: <u>Home</u>	good white sand	11	163
(Domestic Irrigation Municipal, Industrial, Other)			


Information upon completion of well:

- (1) Diameter 4 inches.
- (2) Total Depth 163 feet.
- (3) Water Level 119 feet below top of ground.
- (4) Cased to 158, Size 4".
- (5) Screen: Size 4", Length 5 ft.
- (6) Were any formations sealed against pollution?
 yes, no.

If YES depth of formation _____

Why _____

Drillers Remarks: _____

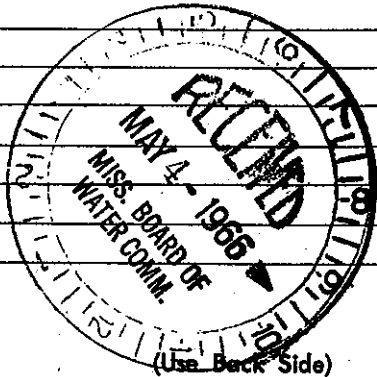

Well No. 13

Mail this copy to Board of Water Commissioners 429 Miss. St. Jackson, Miss.