

Lamar
H-13
7-13-66

MISSISSIPPI BOARD OF WATER COMMISSIONERS

WATER WELL DRILLERS LOG

Date: 8-13, 1966, Driller: Sgt R. Drilling Service County Lamar
(Name)

(1) Owner of Land: <u>R. F. Thorator</u> (Name)		Description & Color of Materials Sand, Clay, Red Clay, Shell, etc.	Thick- ness Feet	Depth Feet
<u>Routel pennis Miss.</u> (Address)		<u>Red + white clay</u>	<u>0</u>	<u>20</u>
		<u>white clay</u>	<u>20</u>	<u>40</u>
		<u>Sandy + Gravel</u>	<u>40</u>	<u>60</u>
		<u>white sand</u>	<u>60</u>	<u>71</u>
(2) Location: <u>SW 1/4, SW 1/4, Sec. 3 T. 21 N. R. 14 W.</u>				
Previous <u>4</u> miles <u>North</u> , of <u>pennis</u> (distance) (direction) (Nearest Town)				
Topography: <u>Hilly</u> (Hilly) (Flat) (Level)				
(4) Purpose of Well: <u>Home</u> (Domestic Irrigation Municipal, Industrial, Other)				

Information upon completion of well:

(1) Diameter 2 inches.

(2) Total Depth 71 feet.

(3) Water Level 45 feet below top of ground.

(4) Cased to 76 ft, Size 2"


(5) Screen: Size 2", Length 5 ft.

(6) Were any formations sealed against pollution?
 yes, no.

If YES depth of formation _____

Why _____

Drillers Remarks: _____

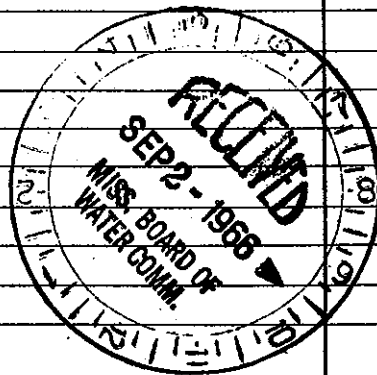

Well No.

(Use Back Side)