

Lamar
H 44
8-1-68

MISSISSIPPI
BOARD OF WATER COMMISSIONERS
416 North State Street
Jackson, Mississippi 39201

CODED

CODED

WATER WELL DRILLERS LOG

8-1-1968 S & R Lamar
date well completed firm name county well located

LANDOWNER: Clara Martin

description of formations encountered from to

Pennis Miss
(mailing address)

Sand	0	10
Clay	10	15
Gravelly Clay	15	30
C.W. & Sand	30	45


WELL LOCATION:
sec. 34 T. 3 N. R. 14 E.
S W
2 miles N of Pennis
(distance) (direction) (nearest town)

WELL PURPOSE: Home
(home, irrigation, municipal, industrial)

WELL COMPLETION DATA:

- (1) diameter (inches) 2"
- (2) total depth (feet) 45 ft
- (3) static water level (feet) 15 below above top of ground
- (4) casing galv. 40
(material) (depth)
2" if telescope see back.
(size)
- (5) screen 5 ft 40
(length) (depth to top)
2" galv.
(size) (material)
- (6) pump 1/2 800
(HP) (yield gpm)
best
(type power)
- (7) electric log no
(yes or no)
- (organization running log)
- (8) how well bottom plugged

CODED

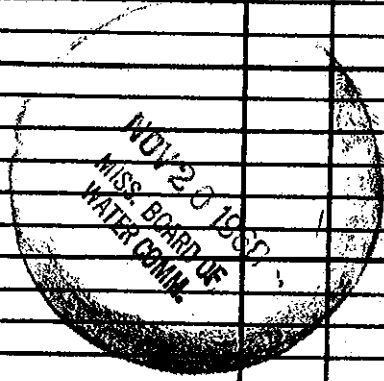

DRILLERS REMARKS: