

INDEXED

Lamar
H45
9-68

MISSISSIPPI
BOARD OF WATER COMMISSIONERS
416 North State Street
Jackson, Mississippi 39201


WATER WELL DRILLERS LOG

Sept 1968 date well completed James Drilling Co. James firm name county well located

LANDOWNER: W. C. Long
Permit (mailing address)
WELL LOCATION:
sec. 5 T. 3 N. R. 14 E
4 1/2 miles S. SE of OAK Grove
(distance) (direction) (nearest town)
WELL PURPOSE: Home
(home, irrigation, municipal, industrial)

description of formations encountered	from	to
<u>Clay</u>	<u>0</u>	<u>12</u>
<u>Red Sand</u>	<u>13</u>	<u>14</u>
<u>Red Clay</u>	<u>14</u>	<u>28</u>
<u>Brown Clay</u>	<u>28</u>	<u>104</u>
<u>Silt Sand</u>	<u>104</u>	<u>116</u>
<u>Clay & Shale</u>	<u>116</u>	<u>225</u>
<u>Sand</u>	<u>225</u>	<u>265</u>

WELL COMPLETION DATA:
(1) diameter (inches) 2
(2) total depth (feet) 260
(3) static water level (feet) 150 ^{below} / _{above} top of ground.
(4) casing PVC 260
(material) (depth)
(size) if telescope see back.
(5) screen 5 260
(length) (depth to top)
2 PVC
(size) (material)
(6) pump 1 1/2 4 1/2
(HP) (yield gpm)
Electric
(type power)
(7) electric log No
(yes or no)
(organization running log)
(8) how well bottom plugged Yes

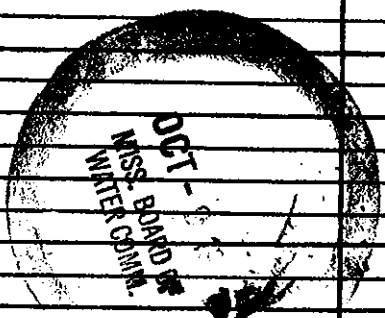

DRILLERS REMARKS:

265