

742  
712  
198  
12/12  
12/12  
Rembe  
H 46  
9-28-68

MISSISSIPPI  
BOARD OF WATER COMMISSIONERS  
416 North State Street  
Jackson, Mississippi 39201

CODED

WATER WELL DRILLERS LOG

Sept 28 1968 Time Drilling Lamar  
date well completed firm name county well located


LANDOWNER: Dr. Emmitt Harris  
Permie  
(mailing address)

description of formations encountered	from	to
<u>Clay</u>	<u>0</u>	<u>80</u>
<u>fine sand</u>	<u>80</u>	<u>92</u>
<u>gray clay</u>	<u>92</u>	<u>160</u>
<u>sand shell</u>	<u>160</u>	<u>178</u>
<u>shale</u>	<u>178</u>	<u>240</u>
<u>blue clay</u>	<u>240</u>	<u>390</u>
<u>shale</u>	<u>390</u>	<u>560</u>
<u>clay blue</u>	<u>560</u>	<u>740</u>
<u>sand</u>	<u>740</u>	<u>798</u>

WELL LOCATION:  
sec. 22 T. 3 N. R. 14 E  
5 miles N of Permie  
(distance) (direction) (nearest town)

WELL PURPOSE: home  
(home, irrigation, municipal, industrial)

- WELL COMPLETION DATA:
- (1) diameter (inches) 2
  - (2) total depth (feet) 778
  - (3) static water level (feet) 141 <sup>below</sup> above top of ground.
  - (4) casing galv. 763  
(material) (depth)  
(size) if telescope see back.
  - (5) screen 15 763  
(length) (depth to top)  
2 Stainless Steel  
(size) (material)
  - (6) pump 2 7 1/2  
(HP) (yield, gpm)  
elec.  
(type power)
  - (7) electric log no  
(yes or no)  
(organization running log)
  - (8) how well bottom plugged valve

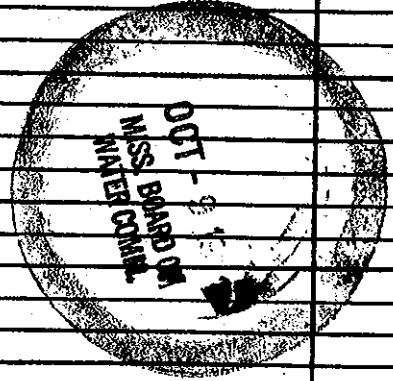

DRILLERS REMARKS: \_\_\_\_\_

778