State '	Well Report	For Office Line Only
County: Lamar 073	Part 1	For Office Use Only:
Mississippi Departm	ent of Environmental Quality I and Water Resources	Aquifer:
P.O. P.O.	. Box 10631	
	MS 39289-0631 1)961-5210	L. S. Elevation:
(601)	601)354-6938 (fax)	
Rouper document of the prepared by the driller in detail and filed with the Department within		
30 days of completion of drilling of the well.		
Well Owner Information		Location
Owner Name Tellus Operating Group	Latitude:°'	_" Longitude:°'"
Mailing Address: 4 Gulf Camp Circle	Method of Lat/Long (circle or	ne): Conventional Survey,
		I GPS, Survey-grade GPS
Lumberton US 39455 City State Zip Code	¹ 4 ¹ 4 Sec <u>.33</u>	
$\frac{City}{Telephone No. (\underline{601}) \underline{796} - 4243}$	Distance Direction	of Bayterville
Well Data		
Purpose of Well (circle one) Home Industrial Public Supply Irrigation Fish Culture Other: Rig Supply		
Date well drilling started: 4-2-05 Da	te well drilling completed:	2-05
If flowing, method of flow regulation: Valve Othe	(describe)	
Static Water Level: _/60feet above or below (circle on	e) land surface Date measured:	4-2-05
Method of Measurement (circle one) steel tape electric ta		
Hole depth: 360 Well depth: 360	Well grouted to a depth of	<u>10</u> feet
	ix	Dur
Casing length: <u>340</u> feet Casing diameter: <u>411</u> inches Type of casing: <u>PUC</u>		
Screen length: 20 feet Screen diameter: 4^{11} inches Type of screen: PVC		
Screen slot size: <u>1020</u> inches Setting depth: From <u>340</u> feet to <u>360</u> feet		
Type of completion (circle all applicable): Gravel packet Underreamed Telescoped Open hole Natural Development		
Other (describe):		
Top of lap pipe or reduction in casing:feet. If telescoped or more than one screen, describe on back of page		
Logs run (circle all applicable): No log run Electric Gamma l	ay Density Sonic Neutron	Other:
Name of organization running log(s): I certify that the well was drilled, constructed, and completed	n accordance with all annlicable	
I certify that the well was drilled, constructed, and completed Department of Environmental Quality and/or the Mississippi		
Department of Environmental Quanty and/or the mississippi	Color manage of anomen LoBarmon	1
Rayborn Drilling, Inc. 0-60 - Man		
Print Name of Water Well Contractor and License No.	Signature	of Water Well Contractor
	· · · · · · · · · · · · · · · · · · ·	
		RECEIVE
		ADR 26 2005

·

, '

APR 2 6 2005 BY: OLWR

• • • • • • • • • • • • • • • • • • • •	LL REPORT	
County: Lama Permit #: Driller: Gav y Rayborn Dete completed; #-2-05	art 2 For Office Use Only: Completion Report Aquifer: t of Environmental Quality Aquifer: Maximum Advances Well #: 539289-0631 Well #: 961-5210 Elevation: Load filed with the Department within 30 days of the	
This report should be prepared by the pump installer in detain installation of pump. Well Owner Information	Well Location	
Owner Name: Tellus Operating Group Mailing Address: <u>4 Gulf Camp Circle</u> <u>Lumberton, Ms 39455</u> City State Zip Code	Latitude: Longitude: Method of Lat/Long (circle one): Conventional Survey, USGS quad, Hand-held GPS, Survey-grade GPS 1/4 1/4 Sec_33 Twn 2N Rng_16W Distance Direction	
Telephone No. (601) 796 - 4243	Miles N of Boxteruille	
Pump Type Circle one	Power Type Circle one	
Air Lift Jet Submersible	Diesel Engine Gasoline Engine Natural Gas	
Bucket Piston Turbine	Electric Motor Hand Tractor PTO	
Centrifugal Rotary Flowing Well	Windmill Other (specify):	
Other (specify): Date Pump Installed: <u>05</u> Rated Pump Capacity: Gallons Per Minute	Horse Power Rating of Motor: Setting Depth: feet Number of Stages:	
Pump Test Data	Method of Measuring Water Level	
Date Well Tested: $(-) - 05$ Static Water Level (A): $(-)$ Feet Below Land Surface Pumping Water Level (B):Feet Below Land Surface Drawdown [(B) – (A)]:Feet Below Land Surface	Circle one Air Line Electric Measuring Line Steel Tape Other (specify):	
Test Pumping Rate:Gallons Per Minute Duration of Pump Test (minimum 4 hours):hours	Well yielded GPM with a drawdown of feet after hours of pumping	
I HEREBY CERTIFY that the above statements are true to the best Rayborn Drilling, Inc. 0-60 Print Name of Pump Installer and License No. (if applicable)	Signature of Pump Installer APR 2.6.200	

٤


۰.

APR 2 6 2005 BY: OLWR If well telescopes please sketch below and show depths.

Ground Level

丁-318 Description of Formations Encountered From То 0 Red Sand E Clay Mi SC 80 Fine 60 320

If more than one screen, show location of each on sketch

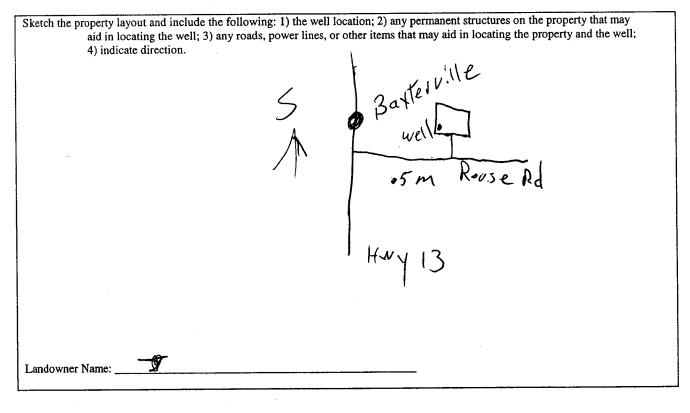

Signature of Water Well Contractor

RECEIVED APR 2 6 2005 BY: OLWR