2nd of 2 wells	on Cameron 3	51-1-412H
State We	ell Report	
State Well Report Part 1 Part 1 Mississippi Department of Environmental Quality Office of Land and Water Resources P.O. Box 10631 Jackson, MS 39289-0631 (601)961-5210 (601)354-6938 (fax)		For Office Use Only: Aquifer:
State Law requires that this report be prepared by the 30 days of completion of drilling of the well.		
Well Owner Information		Location $\mathcal{A} \mathcal{A} \mathcal{A} \mathcal{A} \mathcal{A} \mathcal{A} \mathcal{A} \mathcal{A} $
Owner Name Penn-Va Oil 3 Gas	44	_" Longitude: <u>89 • 38 .45 "</u>
Mailing Address: 2550 E. Stone Drive	Method of Lat/Long (circle o	ne): Conventional Survey,
Suite 110		1 GPS, Survey-grade GPS
Kingsport TN 37760 City State Zip Code	NE 1/4 500 1/4 Sec_ 31	
City State Zip Code Telephone No. (601) 731-4333	$\frac{\text{NE}}{3}$ Direction $\frac{1}{3}$ Miles $\frac{1}{3}$	of Baxtery, 11e
Well I	L Data	<u></u>
Top of lap pipe or reduction in casing:feet. If t	well drilling completed:	$\frac{2 9 0}{10}$ $\frac{10}{\text{feet}}$ $\frac{PVC}{PVC}$ $\frac{100}{\text{feet}}$ on hole Natural Development creeen, describe on back of page
Logs run (circle all applicable) No log run Electric Gamma Ray	y Density Sonic Neutron	Other:
Name of organization running log(s): I certify that the well was drilled, constructed, and completed in	accordance with all applicabl	e requirements of the Mississippi
Department of Environmental Quality and/or the Mississippi De	partment of Health regulation	ns and state laws.
RAYBORN DRILLING, INC O-	60 7	-8
Print Name of Water Well Contractor-and License No.	Signature	of Water Well Contractor
		MAR I > 2010
	· · ·	BY: OLWP

art 2	For Office Use Only:
art 2	For Office Use Only
STATE WELL REPORT Part 2 Pump Installer's Completion Report Mississippi Department of Environmental Quality Office of Land and Water Resources P.O. Box 10631 Jackson, MS 39289-0631 (601)961-5210 (601)354-6938 (fax)	
	ll LocationLongitude:
Method of Lat/Long (circle one): Conventional Survey,	
USGS quad, Hand-held GPS, Survey-grade GPS	
$\underline{ \frac{14}{14} \text{ Sec } \underline{31}}_{\text{Distance}} \text{ Twn} \underline{2N}_{\text{Rng}} \underline{16W}}$	
<u>3</u> Miles <u>W</u> of <u>Baxteru</u> , lle	
	ower Type Circle one
	r (specify):
Horse Power Rating of Moto	$r: \underline{-5} \overline{r}$
Number of Stages:	8
	leasuring Water Level
	Circle one
	easuring Line Steel Tape
Other (specify):	
For flowing well, measured	shut in head:fe
-	
i de la companya de l	
st of my knowledge.	-
Signature of Pump	Installer
Signature of Pump	RECEIVE
	Box 10631 MS 39289-0631)961-5210 54-6938 (fax) all and filed with the Department Well Latitude: Method of Lat/Long (circle of USGS quad, Hand 1414 Sec Distance Direction 3_Miles Diesel Engine Gasol Electric Motor Hand Windmill Other Horse Power Rating of Motor Setting Depth: Number of Stages: Method of M

.

BY: OLWA

If well telescopes please sketch below and show depths.


Ground Level

Description of Formations Encountered	From	То
Chalk	0	40
Sand a Gravel	40	100
	1	
	1	
	+-	
		<u> </u>
		<u> </u>

J337

BY: OLWR

If more than one screen, show location of each on sketch

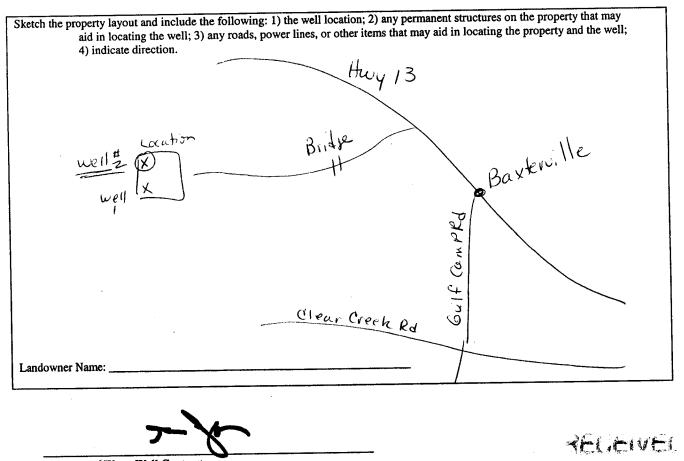

Signature of Water Well Contractor