STATE WELL REPORT				
County: Lamar Permit #: Driller: Josh Boone Date drilling completed: 08/25/2021 State Law requires that this report be prepared	Part 1 Driller's Log ppi Department of Environmental Quality Office of Land and Water Resources P.O. Box 2309 Jackson, MS 39225-2309 (601)961-5555 (601)961-5528 (fax) ared by the license holder responsible for the	he work and filed with	 RECEIVED	
Department at the above address within 30    Well Owner Information    (Landowner if borehole is not for a water    Owner Name:  Sandy Herrington    Mailing Address:  121 Tatum salt de    Lumberton  Mississipp  3    City  State  3    Telephone No.	Well or Bore    Well or Bore    Latitude: 31.0950830 Lor    Ome    Method of Lat/Long (check one    USGS quad, Hand-held G    99455    Zip Code	hole Location ngitude: <u>-89.5941</u> ): Conventional Surve PS <u>V</u> , Survey-grade	y, GPS {16W	
Date drilling started: 08/25/2021 Date drilling of Location of the source of any surface water used Method of dosing and volume of Chlorine used in Logs run (check <i>all applicable</i> ): No log run Election Name of organization running log(s):	d for drilling: Running creek n drilling and development: Granular tric Gamma Ray Density Sonic Neutro Geotechnical/Geological Investigation Other (describe)	ted chlorine		
Other (describe):	alve Other ( <i>describe</i> ) e or [2]below] land surface Date measur eck one) e Electric tape[2]Air line Other ( <i>describe</i> ) f: 10 feet Type of grout ( <i>check one</i> )[2] meter: 4inches Type of c ameter: 4	ed: 08/25/202 ): Neat Cement Benton casing: PVC screen: Saw sloc o 130 fe Natural Development	1 nite Mix Dt eet	

County:	Lamar
Permit #:	
r ernne ".	




For Office Use Only:

Well #: <u>J378</u>

## The sketch below only required for water wells

If well telescopes, show depths on sketch.

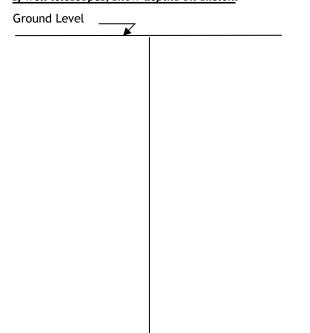

Description of formations encountered must be provided for all wells and boreholes, unless specifically exempted by regulations

Description of Formations Encountered	From (depth)	To (depth)
Top soil	Ground level	2
Clay	2	16
Sand gravel	16	130

If more than one screen, show location of each on sketch


Sketch the property layout and include the following:

1) the well location

2) any permanent structures on the property that may aid in locating the well

3) any roads, power lines, or other items that may aid in locating the property and the well

4) north arrow

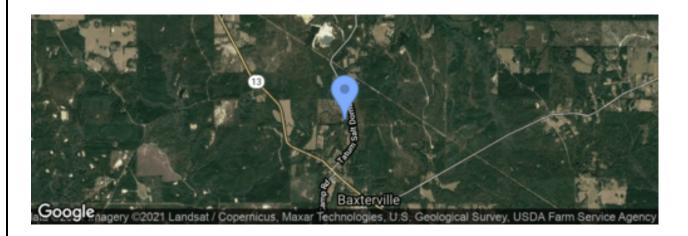

Landowner Name: Sandy Herrington

I HEREBY CERTIFY that the well/borehole was drilled, constructed, and completed in accordance with all applicable requirements of the Mississippi Department of Environmental Quality and the Mississippi Department of Health regulations, if applicable, and state laws.

 W

Josh Boone Signature of Licensee

Josh Boone 868309/03/2021Print Name of Responsible Licensee and License No.Date

Form: OLWR-SWR-1B (4/13)