

JAN-16-2002 11:25A FROM:

TO:16013600535

P:1

State Well Report

Part I

Mississippi Department of Environmental Quality
 Office of Land and Water Resources
 P.O. Box 10631
 Jackson, MS 39289-0631
 (601)961-5210
 (601)354-6938 (fax)

County: Leflore
 Permit #: _____
 Driller: Travis Boone
 Date drilling completed: 12-18-07

For Office Use Only:
 Aquifer: _____
 Well #: K-201
 L. S. Elevation: _____
 B-log #: _____

State Law requires that this report be prepared by the driller in detail and filed with the Department within 30 days of completion of drilling of the well.

Well Owner Information		Well Location	
Owner Name: <u>Raymond Fuller</u>	Latitude: _____	Longitude: _____	
Mailing Address: <u>53 Summer Creek Ln Dr.</u>	Method of Lat/Long (circle one): Conventional Survey,		
<u>Pineville, MS 39475</u>	USGS quad, Hand-held GPS, Survey-grade GPS		
City State Zip Code	<u>W Sec 24 Twn 2N Rng 15W</u>		
Telephone No. () _____	Distance: <u>2 1/2 Miles</u>	Direction: <u>SW</u>	Nearest Town: <u>PINEVILLE</u>
Well Data			
Purpose of Well (circle one) <u>Home</u> Industrial Public Supply Irrigation Fish Culture Other: _____			
Date well drilling started: <u>12-18-07</u>		Date well drilling completed: <u>12-18-07</u>	
If flowing, method of flow regulation: Valve _____ Other (describe) _____			
Static Water Level: <u>100</u> feet above or <u>below</u> (circle one) land surface		Date measured: <u>12-18-07</u>	
Method of Measurement (circle one) steel tape electric tape air line other: <u>String Line</u>			
Hole depth: _____		Well depth: <u>130</u> Well grouted to a depth of <u>10</u> feet	
Type of grout (circle one): <u>Concrete</u> Bentonite Mix			
Casing length: _____ feet		Casing diameter: <u>4</u> inches Type of casing: <u>sch 40</u>	
Screen length: <u>20</u> feet		Screen diameter: <u>4</u> inches Type of screen: <u>sch 40</u>	
Screen slot size: <u>8</u> inches		Setting depth: From <u>110</u> feet to <u>130</u> feet	
Type of completion (circle all applicable): <u>Gravel packed</u> Underreamed Telescoped Open hole Natural Development			
Other (describe): _____			
Top of lap pipe or reduction in casing: _____ feet. If telescoped or more than one screen, describe on back of page			
Logs run (circle all applicable): No log run Electric Gamma Ray Density Sonic Neutron Other: _____			
Name of organization running log(s): _____			
I certify that the well was drilled, constructed, and completed in accordance with all applicable requirements of the Mississippi Department of Environmental Quality and/or the Mississippi Department of Health regulations and state laws.			
Print Name of Water Well Contractor and License No. <u>Travis Boone 0-514</u>		Signature of Water Well Contractor <u>Travis Boone</u>	

RECEIVED

JAN 24 2008

BY: OLWR


JAN-16-2002 11:25A FROM:

TO:16013600535

P:3

K-201

If well telescopes please sketch below and show depths.

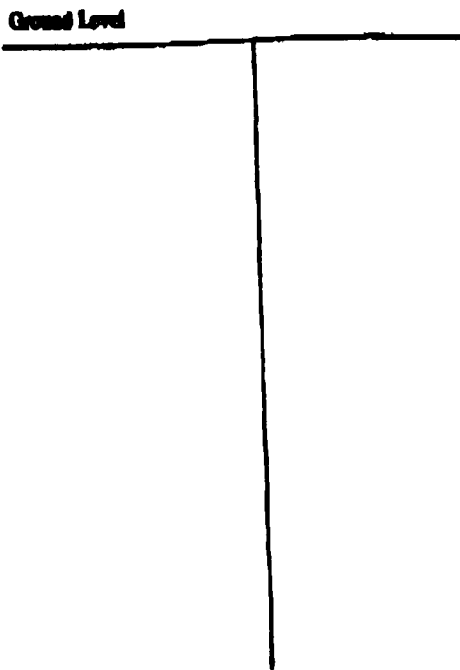

Description of Permeable Encounters	From	To
sand	0	95
(clay)	25	85
sand	85	130

If more than one screen, show location of each on sketch

Sketch the property layout and include the following: 1) the well location; 2) any permanent structures on the property that may aid in locating the well; 3) any roads, power lines, or other items that may aid in locating the property and the well; 4) indicate direction.

Landowner Name: Raymond Fuller

Thomas B...
Signature of Well Well Constructor

RECEIVED
JAN 24 2008
BY: OLWR

JAN-16-2002 11:25A FROM:

TO:16013600535

P:2

STATE WELL REPORT

Part 2

Pump Installer's Completion Report
 Mississippi Department of Environmental Quality
 Office of Land and Water Resources
 P.O. Box 10631
 Jackson, MS 39229-0631
 (601)961-5210
 (601)354-6938 (fax)

County: Lamar
 Permit #: _____
 Driller: Travis Boone
 Date completed: 12-18-07

For Office Use Only
 Aquifer: _____
 Well #: K-201
 Elevation: _____

This report should be prepared by the pump installer in detail and filed with the Department within 30 days of the installation of pump.

Well Owner Information	Well Location
Owner Name: <u>Raymond Fuller</u>	Latitude: _____ Longitude: _____
Mailing Address: <u>53 Jimmie Creek Dr.</u>	Method of Lat/Long (circle one): <u>Conventional Survey</u>
<u>Purvis MS 39475</u>	USGS quad, Hand-held GPS, Survey-grade GPS
City: _____ State: _____ Zip Code: _____	<u>14</u> <u>14</u> <u>Sec 24</u> <u>Twp 2N</u> <u>Rng 15W</u>
Telephone No. (_____) _____	Distance: <u>2 1/2</u> miles Direction: <u>SW</u> of Nearest Town: <u>PURVIS</u>

Pump Type Circle one	Power Type Circle one
Air Lift <input type="checkbox"/> Jet <input type="checkbox"/> <u>Submersible</u>	Diesel Engine <input type="checkbox"/> Gasoline Engine <input type="checkbox"/> Natural Gas <input type="checkbox"/>
Bucket <input type="checkbox"/> Piston <input type="checkbox"/> Turbine <input type="checkbox"/>	<u>Electric Motor</u> <input type="checkbox"/> Hand <input type="checkbox"/> Tractor PTO <input type="checkbox"/>
Centrifugal <input type="checkbox"/> Rotary <input type="checkbox"/> Flowing Well <input type="checkbox"/>	Windmill <input type="checkbox"/> Other (specify): _____
Other (specify): _____	HP or Power Rating of Motor: <u>1</u>
Date Pump Installed: <u>12-18-07</u>	Setting Depth: <u>100</u> feet
Rated Pump Capacity: <u>10</u> Gallons Per Minute	Number of Stages: _____

Pump Test Data	Method of Measuring Water Level Circle one
Date Well Tested: <u>12-18-07</u>	Air Line <input type="checkbox"/> Electric Measuring Line <input type="checkbox"/> Steel Tape <input type="checkbox"/>
Static Water Level (A): <u>80</u> Feet Below Land Surface	Other (specify): <u>String Line</u>
Pumping Water Level (B): _____ Feet Below Land Surface	For flowing well, measured static in head: _____ feet
Drawdown (B) - (A): _____ Feet Below Land Surface	Well yielded _____ GPM with a drawdown of _____ feet after _____ hours of pumping
Test Pumping Rate: <u>16.0E</u> Gallons Per Minute	
Duration of Pump Test (minimum 4 hours): _____ hours	

I HEREBY CERTIFY that the above statements are true to the best of my knowledge.

Travis Boone _____
 Print Name of Pump Installer and License No. (if applicable) Signature of Pump Installer

RECEIVED
 JAN 24 2008
 BY: OLWR