

MISSISSIPPI BOARD OF WATER COMMISSIONERS

MAR. *Ans. info to locate*

WATER WELL LOG

12.5  
10.4

Date: 12-7-60 1960 Driller: HERMAN PARKER County Forrest

(1) Owner of Land:	Description & Color of Materials Sand, Clay, Red Clay, Shell, etc.	Thick- ness Feet	Depth Feet
<i>* Inter Williams Park Co.</i>	<i>SANDY CLAY</i>	<i>45</i>	<i>45</i>
<i>LUMBERTON, MISS</i>	<i>CHALK</i>	<i>60</i>	<i>105</i>
(2) Location: <i>SW 1/4, SE 1/4, Sec. 1, T13R16</i>	<i>RED SAND</i>	<i>24</i>	<i>174</i>
<i>2</i> miles <i>South</i> of <i>Batesville</i>			<i>174</i>
(3) Topography: <i>Hilly</i>			
(4) Purpose of Well: <i>Domestic</i>			

Information upon completion of well:

(1) Diameter: 2 inches.

(2) Total Depth: 174 feet.

(3) Water Level: 91 feet below top of ground.

(4) Cased to: 174, Size: 2"


(5) Screen: Size 2", Length 5'

(6) Were any formations sealed against pollution?  
 yes,  no.

If YES depth of formation \_\_\_\_\_

Why \_\_\_\_\_

Drillers Remarks: *\* Crown Zellerbach new owner*

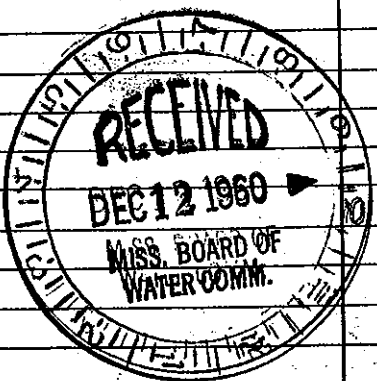

Well No. 9

(Use Back Side)

Mail this copy to Board of Water Commissioners 429 Miss. St. Jackson, Miss.